
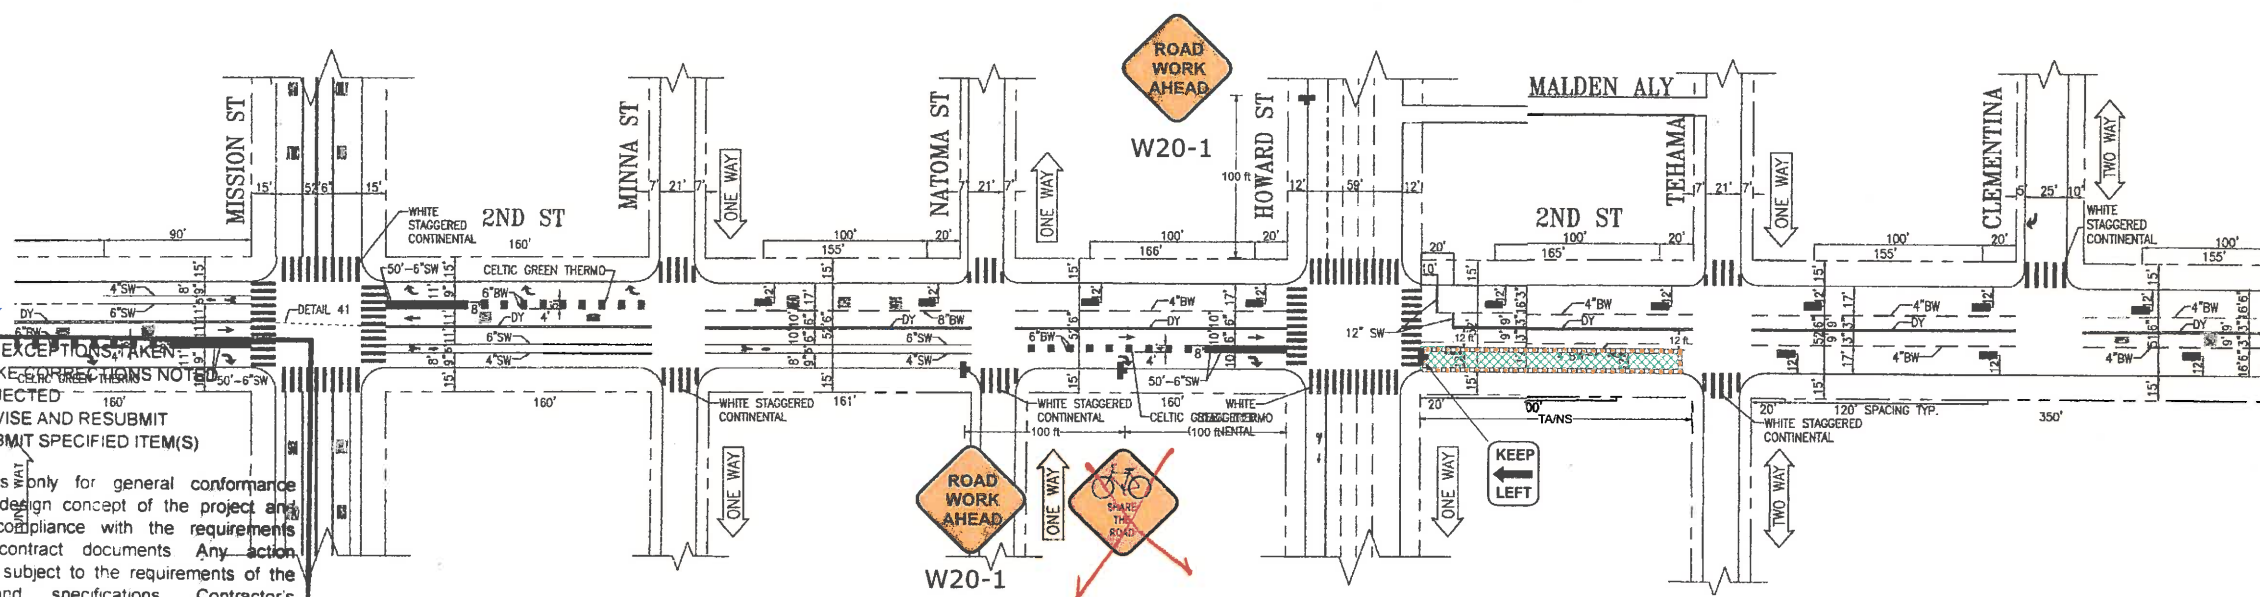


WORK HOUR

TRAFFIC CONTROL PLAN  
1064J - 2ND ST IMPROVEMENTS PROJECT  
ISLAND WORK PLAN - 2ND ST FROM NATOMA ST TO TEHAMA ST

www.invision.com

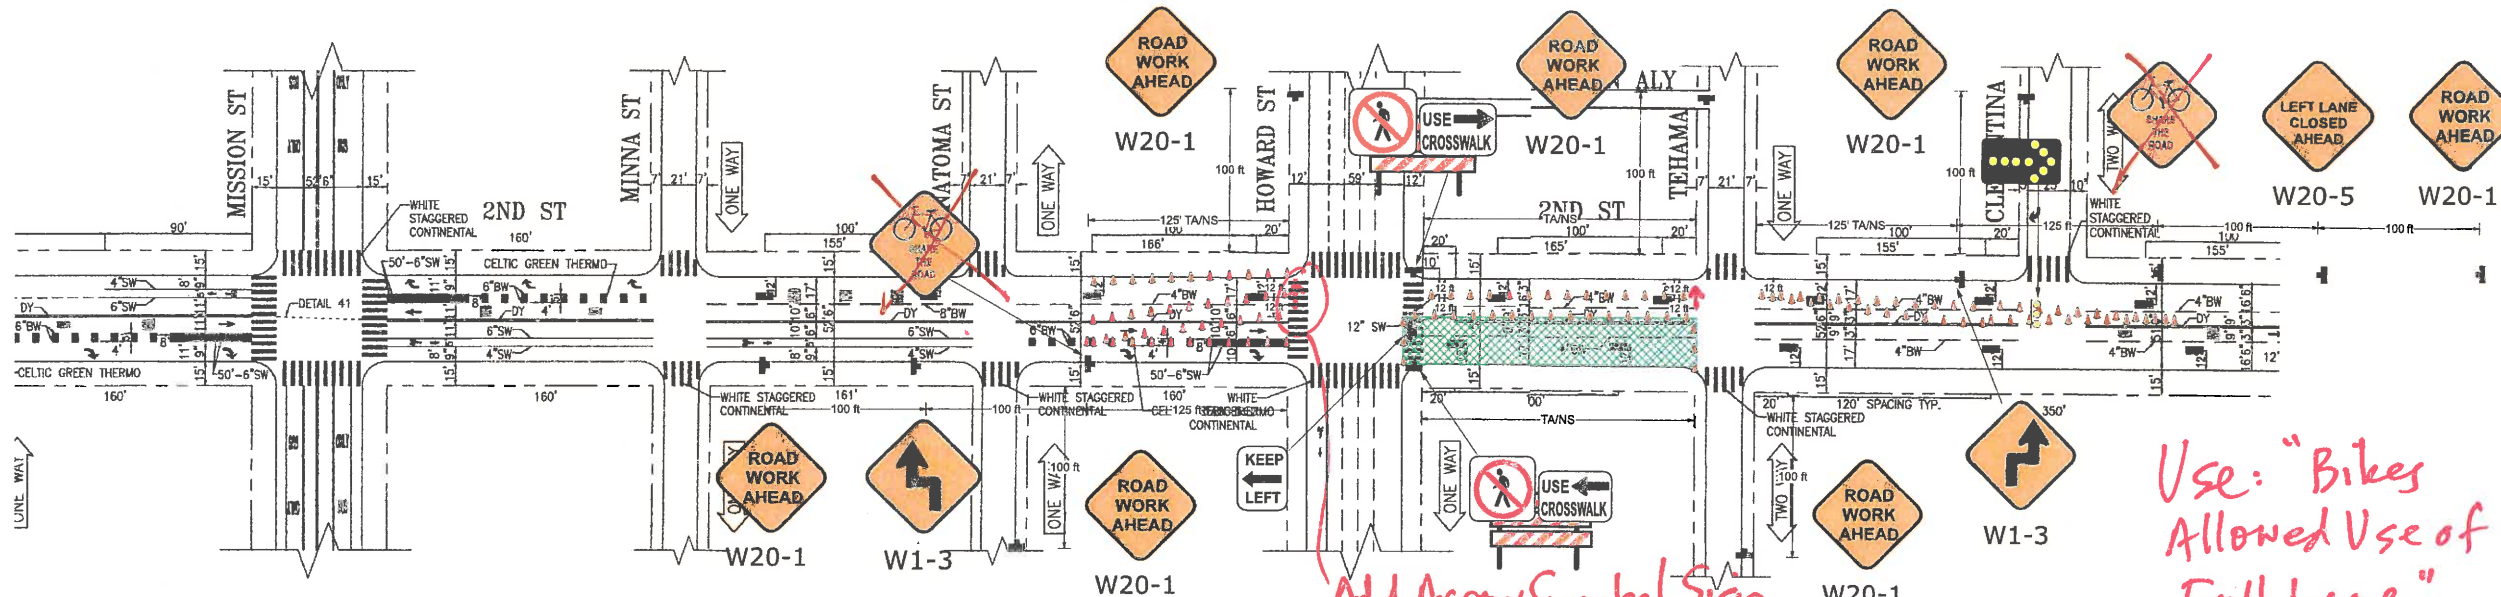

- ☐ NO EXCEPTIONS TAKEN
- ☒ MAKE CORRECTIONS NOTED
- ☐ REJECTED
- ☐ REVISE AND RESUBMIT
- ☐ SUBMIT SPECIFIED ITEM(S)

Review is only for general conformance with the design concept of the project and general compliance with the requirements of the contract documents. Any action shown is subject to the requirements of the plans and specifications. Contractor's responsibilities include, but are not limited to actual dimensions which shall be confirmed and correlated at the job site; preferred fabrication processes and techniques of construction; coordination of the contractor's work with that of all other trades; and the satisfactory performance of the contractor's work.

Sustainable Streets Division  
San Francisco Municipal Transportation Agency  
City and County of San Francisco

By DRS Date 7/24/18

- Legend**
- Type III Barricade
  - 28" Traffic Cone
  - Work Area
  - Sign and Stand
  - Direction of Travel
  - Type III Barricade (Plan View)
  - ADA Pedestrian Barricades
  - NTS Not To Scale
  - TANS Tow-Away/No Stopping
  - Police Officer
  - Flagger
  - Type I Barricade
  - Work Truck
  - Pipe to be installed
  - Existing Utility
  - Flashing Beacon

STREET	TIME	NORTHBOUND	SOUTHEBOUND	EASTBOUND	WESTBOUND
SIDEWALK, CURB RAMP, IRRIGATION AND STREET LIGHTING WORK					
2nd STREET					
Market St to King St (MC)	8AM - 5PM (M-F) 8AM - 6PM (S/S) At Other Times	12:12 12:12 Full Roadway	12:12 12:12 Full Roadway		
Cross Streets for 2nd Street					
Natoma St	8AM - 5PM (M-F) 8AM - 6PM (S/S) At Other Times			Closed@ Closed@ Full Roadway	
Howard St (GG)	10AM - 4PM (M-F) 8AM - 6PM (S/S) At Other Times				3/2:12 3/2:12 Full Roadway
Tehama St	8AM - 5PM (M-F) 8AM - 6PM (S/S) At Other Times				Closed@ Closed@ Full Roadway



Plan Scale  
1" = 50'

**CMC**  
Traffic Control  
Specialists

3450 3rd St, Suite 3G, San Francisco, CA 94124  
Phone: (415) 206-1700 Fax: (415) 206-1711  
Contractor License No. 792059 (Class A & C-31)

Date: 05/16/2018 Author: PM/RC Project: 1064J  
Client: M2 Owner: SFPD Location: SAN FRANCISCO  
TCP: 038 CMC Job #: 1430 REV: 0

**Comments:**

- 1) WORK HOURS:
- 2) THE CONTRACTOR SHALL BE ALLOWED TO WORK AT A MAXIMUM OF 3 INTERSECTIONS AT ANY TIME.
- 3) THE CONTRACTOR SHALL NOT PREVENT OR DELAY THE OPERATION OF MASS TRANSIT VEHICLE AT ANY TIME.
- 4) USE A SIMILAR BUT OPPOSITE CONFIGURATION TO COMPLETE THE YELLOW CURB RAMP SHOWN.