





MATCH LINE "F", STA 32+00  
SEE SHEET SW-6

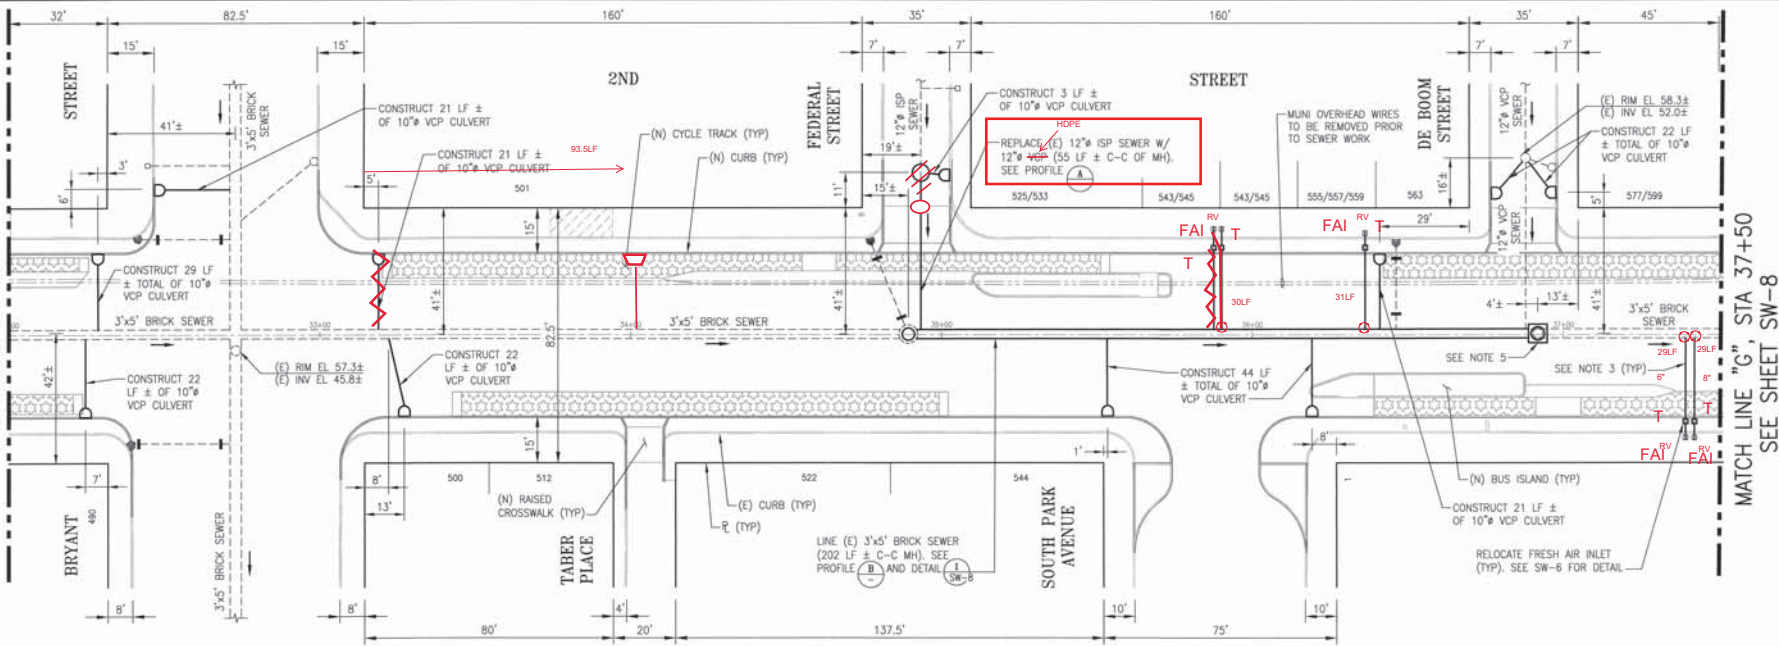

MATCH LINE "G", STA 37+50  
SEE SHEET SW-8

#### NOTES:

- CONTRACTOR SHALL ADJUST MANHOLE FRAMES AND COVERS TO PROPOSED GRADES. REFER TO R-DWGS FOR PROPOSED ELEVATIONS.
- SEE R-DWGS FOR PROPOSED ROADWAY IMPROVEMENTS INCLUDING, BUT NOT LIMITED TO, RAISED CROSSWALKS, BUS ISLANDS, AND VARIOUS BUFFER ZONES.
- CONTRACTOR TO IDENTIFY ALL ACTIVE SIDE SEWERS WITHIN RAISED CYCLE TRACK LIMITS AND REPLACE ALL OF THEM FROM THE CURB TO THE MAIN SEWER. INVESTIGATION OF SIDE SEWERS SHALL BE COMPLETED PER CONTRACT SPECIFICATIONS PRIOR TO REPLACEMENT WORK.
- CONTRACTOR SHALL NOTIFY CITY REPRESENTATIVE IF EXISTING SIDE SEWER CONNECTIONS ARE DEFECTIVE. IF DETERMINED BY CITY REPRESENTATIVE THAT THE CONNECTION REQUIRES REPLACEMENT, SIDE SEWER CONNECTION TO RC SEWERS/RCP/BRICK SHALL BE CONSTRUCTED PER DETAILS ON SW-4. SIDE SEWER CONNECTIONS TO VCP SHALL BE PER CONTRACT SPECIFICATIONS. CITY REPRESENTATIVE MAY ALSO REQUIRE CONTRACTOR TO LINE (E) SIDE SEWERS WITH CIPL.
- REPLACE (E) MANHOLE W/ MODIFIED MANHOLE FOR 3'x5' BRICK SEWERS PER SFPD STD PLANS 87,182 AND 87,184.

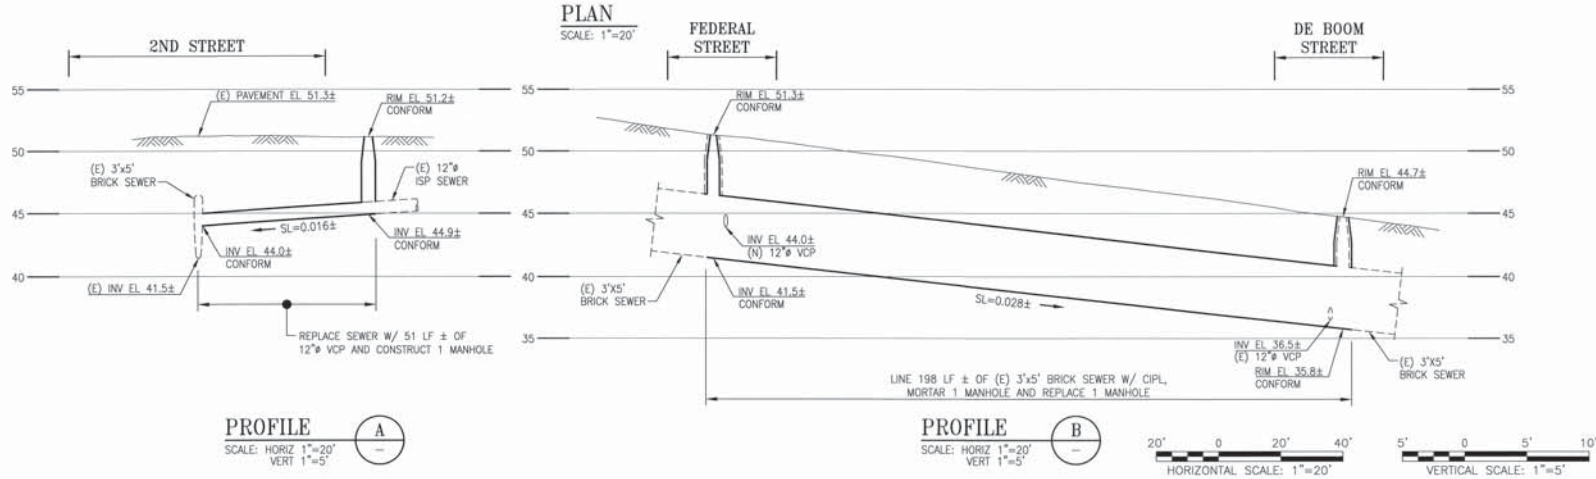

ELEVATION	SEWER SIZED BY
DATE	B.A. 3/31/16
SFVD13	APPROVED BY B.S. 6/5

NO.	DATE	DESCRIPTION	BY	APP.
0	10/16	ISSUED FOR BIDS	AS	LW
TABLE OF REVISIONS				


REFERENCE INFORMATION & FILE NO. OF SURVEYS
289



DESIGN & ENGINEERING  
CITY & COUNTY OF SAN FRANCISCO  
SAN FRANCISCO PUBLIC WORKS  
30 VAN NESS AVENUE, 6TH FLOOR  
SAN FRANCISCO, CA 94102 - 6028

Section Manager	LESLIE WONG
Design Division Manager	KOBAL CHAPRA
Design Manager	PATRICK RIVERA

Drawn	11/19/16
Checked	11/19/16
Designed	11/19/16
Drawn	11/19/16
Checked	11/19/16
Designed	11/19/16

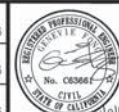

SCALE:	AS NOTED
SHEET OF SHEETS	

2ND STREET STREETSCAPE IMPROVEMENTS PROJECT	CONTRACT NO. 1064J(R)
2ND STREET SEWER REPLACEMENT STATION 32+00 TO 37+50 PLAN AND PROFILES	DRAWING NO. SW-7
	FILE NO. 1064.249
	REV. NO. 0