

R-8 = 149.LF  
35 LF


R-9 = 298 SF  
70 SF.  
142 SF.  
1110 SF.  
114 SF.

R-6 = 1043 SF  
350 SF.  
207 SF.  
375 SF.  
3465 SF  
265 SF

R-11 = 20.16 SF.  
212 SF.

P. Buffer - 212 SF.  
Gutter - 53x61  
= 114 SF.  
C.Track = 265 SF.

9/25/18  
SIGNED: *[Signature]*  
M2 AS BUILT

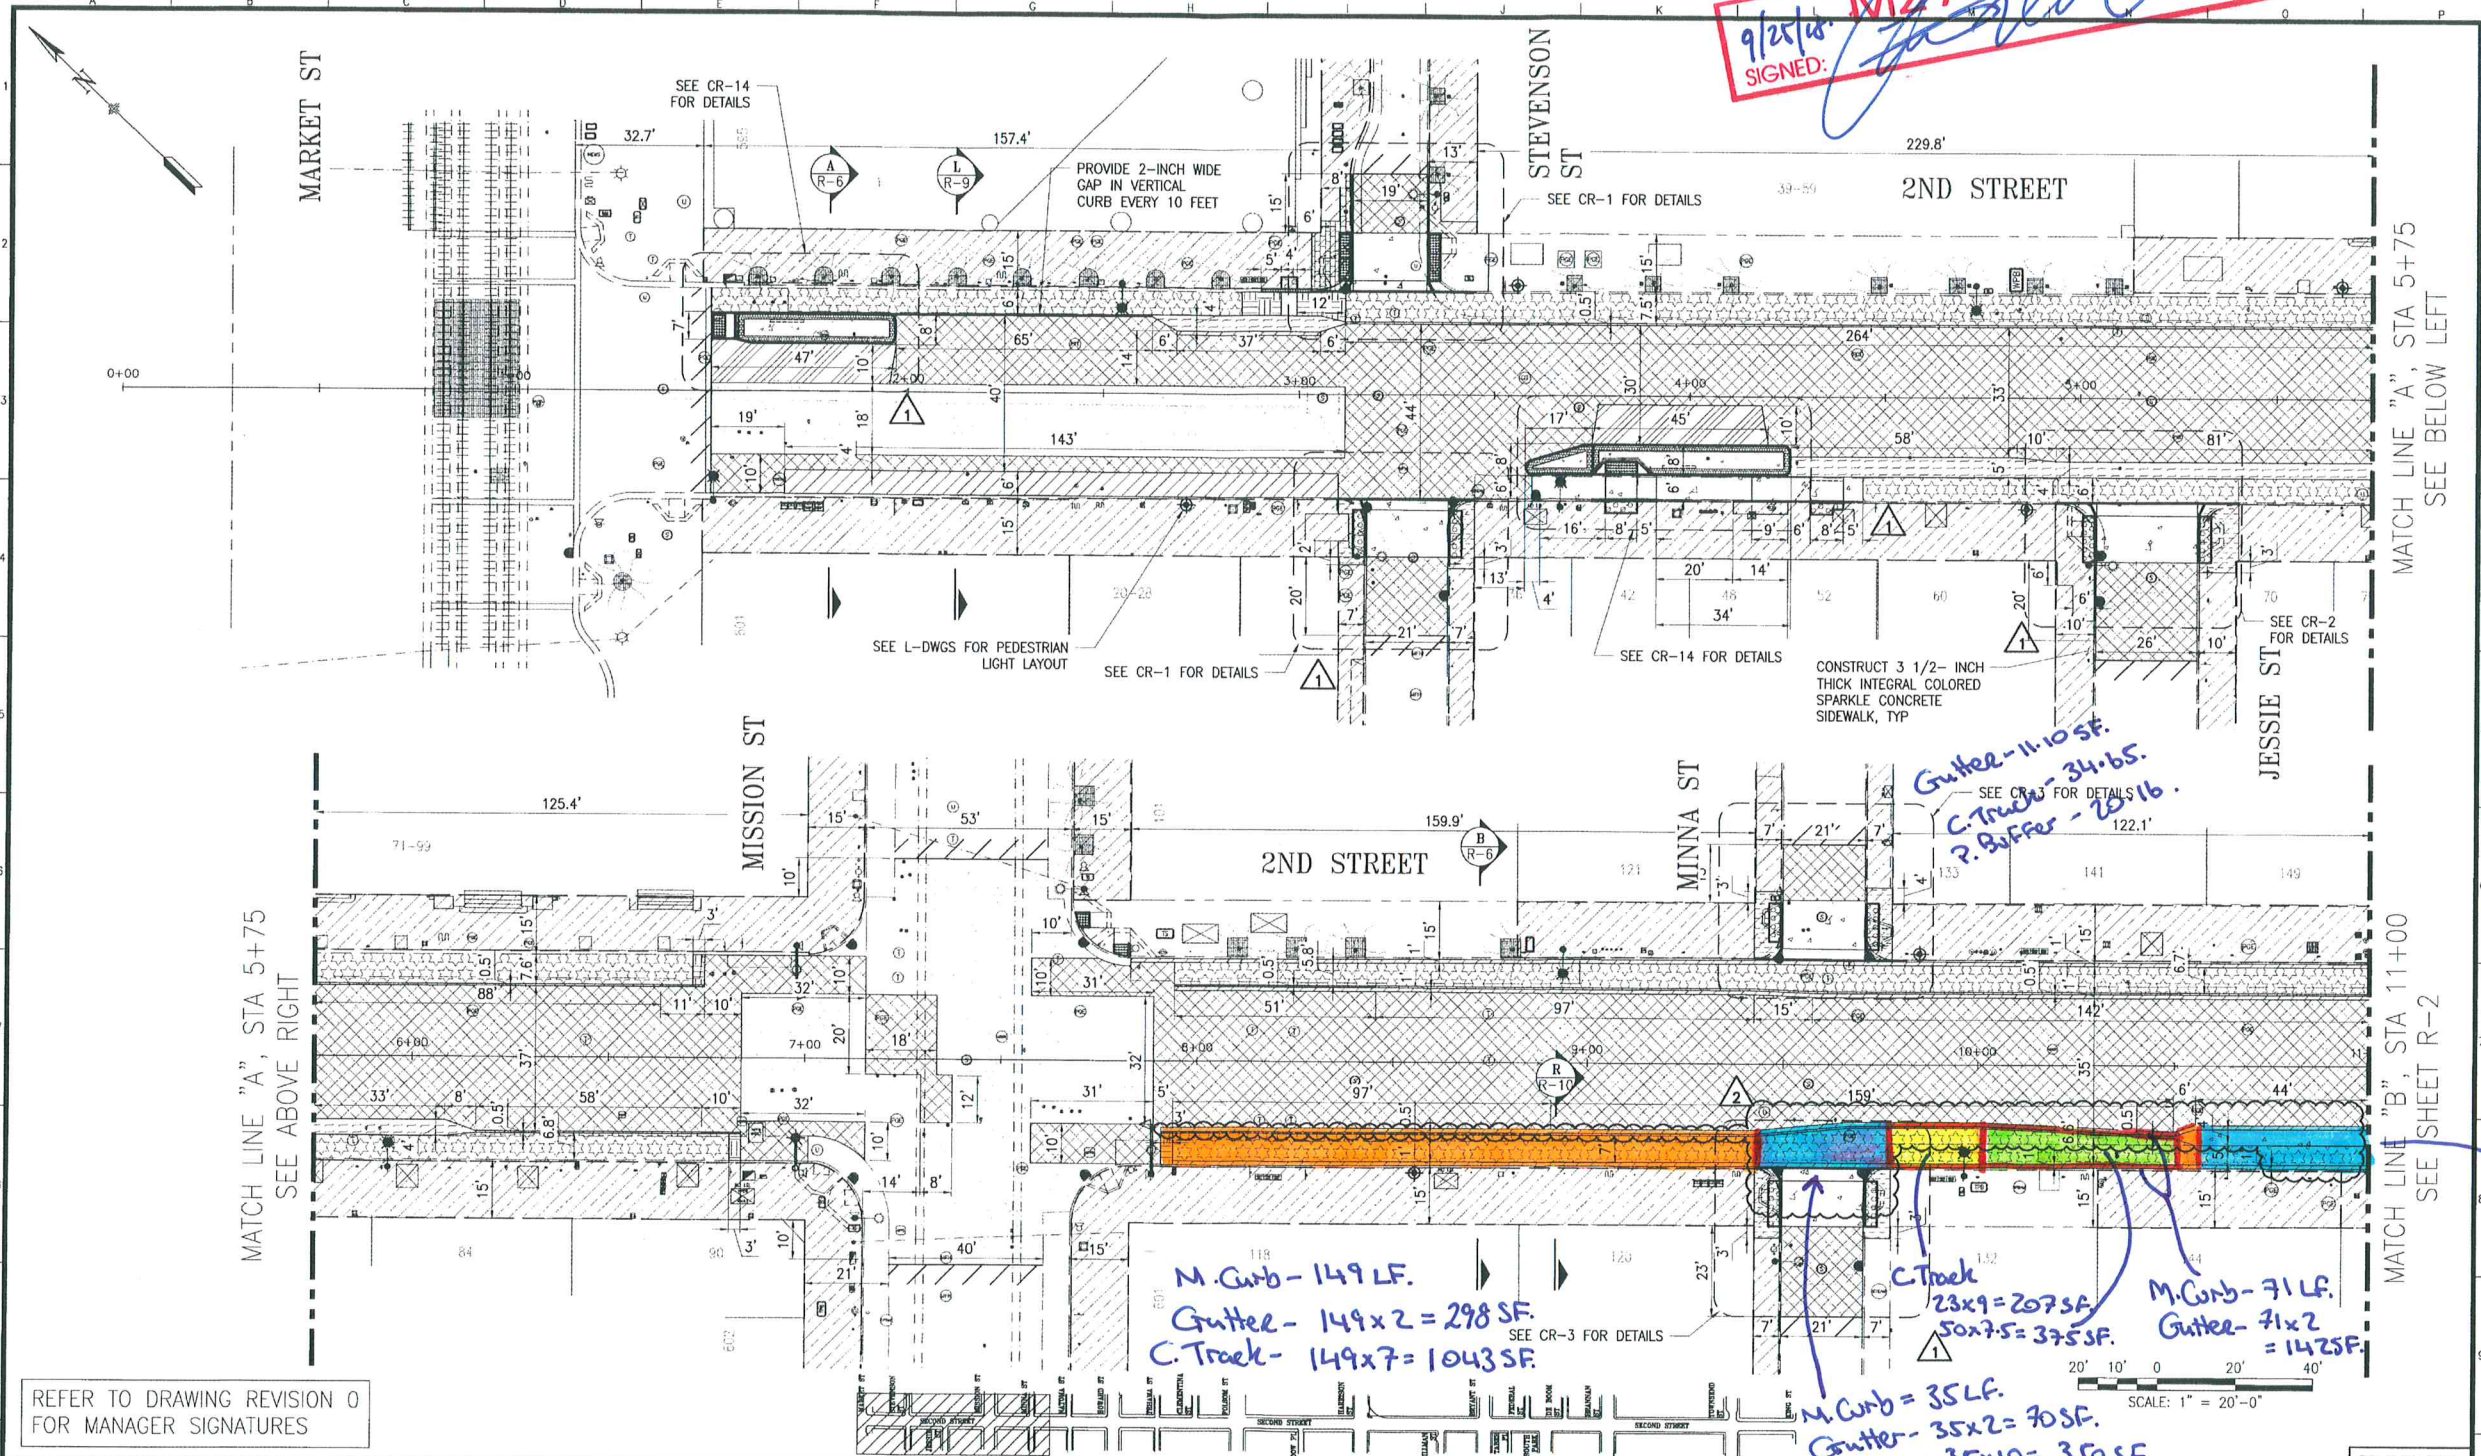

REFER TO DRAWING REVISION 0  
FOR MANAGER SIGNATURES

NO.	DATE	DESCRIPTION	BY	APP.
2	09/18	REVISE CYCLETRACK WIDTH; ADD GUTTER	KC	DMC
1	05/18	REVISE BUS PAD LAYOUT, GRADES, AND DRAINAGE	KC	DMC

TABLE OF REVISIONS  
THIS DRAWING WAS LAST MODIFIED: 09/08/18 13:20, BY: kchang

REFERENCE INFORMATION  
& FILE NO. OF SURVEYS



BUREAU OF DESIGN & ENGINEERING  
PUBLIC WORKS  
CITY & COUNTY OF SAN FRANCISCO  
30 VAN NESS AVENUE, 5TH FLOOR  
SAN FRANCISCO, CA 94102 - 6028

Acting Section Mgr: ERIC KJELSBERG  
Deputy Division Mgr: FERNANDO CISNEROS  
Division Mgr: PATRICK RIVERA

DESIGNED: DATE: K.CHANG 09/18  
DRAWN: DATE: K.CHANG 09/18  
CHECKED: DATE: D.CALLEROS 09/18



SCALE:  
1" = 20'

SHEET OF SHEETS  
SECOND STREET IMPROVEMENT PROJECT  
PAVEMENT PLAN  
2ND STREET  
STATION 0+00 TO 11+00

EHY JO NO. 2835J  
CONTRACT NO.  
1064J (R)  
DRAWING NO.  
R-1  
FILE NO.  
106,159  
REV. NO.  
2

VA1064J SECOND STREET STREETScape IMPROVEMENTS Official Project: TBA DEL TBO ESH-1064J.dwg  
VA1064J SECOND STREET STREETScape IMPROVEMENTS V2 Design Working Drawings (V2 Design Working Drawings) 2017-03-24 10:54 - 2ND S  
VA1064J SECOND STREET STREETScape IMPROVEMENTS V2 Design Working Drawings (V2 Design Working Drawings) 2017-03-24 10:54 - 2ND S  
VA1064J SECOND STREET STREETScape IMPROVEMENTS V2 Design Working Drawings (V2 Design Working Drawings) 2017-03-24 10:54 - 2ND S