





9 Potholes.
 4cy x 9
 = 36 cy.



- NOTES:**
1. CONTRACTOR SHALL ADJUST MANHOLE FRAMES AND COVERS TO PROPOSED GRADES. REFER TO R-DWGS FOR PROPOSED ELEVATIONS.
 2. SEE R-DWGS FOR PROPOSED ROADWAY IMPROVEMENTS INCLUDING, BUT NOT LIMITED TO, RAISED CROSSWALKS, BUS ISLANDS, AND VARIOUS BUFFER ZONES.
 3. CONTRACTOR TO IDENTIFY ALL ACTIVE SIDE SEWERS WITHIN RAISED CYCLE TRACK LIMITS AND REPLACE ALL OF THEM FROM THE CURB TO THE MAIN SEWER. INVESTIGATION OF SIDE SEWERS SHALL BE COMPLETED PER CONTRACT SPECIFICATIONS PRIOR TO REPLACEMENT WORK.
 4. CONTRACTOR SHALL NOTIFY CITY REPRESENTATIVE IF EXISTING SIDE SEWER CONNECTIONS ARE DEFECTIVE. IF DETERMINED BY CITY REPRESENTATIVE THAT THE CONNECTION REQUIRES REPLACEMENT, SIDE SEWER CONNECTION TO RC SEWERS/RCP/BRICK SHALL BE CONSTRUCTED PER DETAILS ON SW-4. SIDE SEWER CONNECTIONS TO VCP SHALL BE PER CONTRACT SPECIFICATIONS. CITY REPRESENTATIVE MAY ALSO REQUIRE CONTRACTOR TO LINE (E) SIDE SEWERS WITH CIPL.

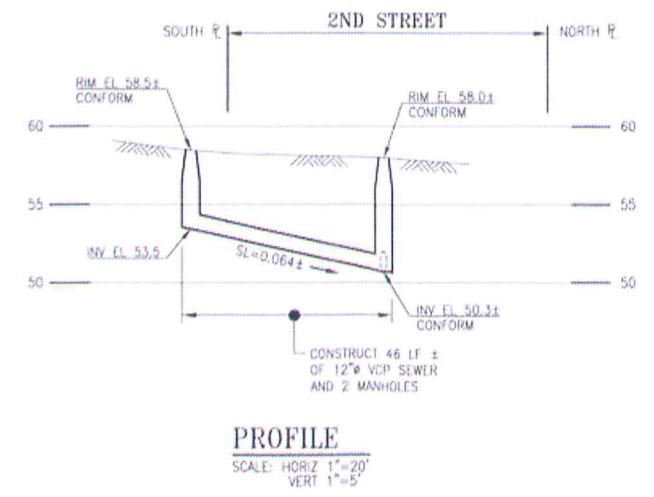

ELEVATION
 DATUM
 SFVD13

				REFERENCE INFORMATION & FILE NO. OF SURVEYS				DESIGN & ENGINEERING CITY & COUNTY OF SAN FRANCISCO SAN FRANCISCO PUBLIC WORKS 30 VAN NESS AVENUE, 8TH FLOOR SAN FRANCISCO, CA 94102 - 5029	DESIGNED: DATE: 11/14/16 J.K./A.S.			SCALE:	2ND STREET STREETSCAPE IMPROVEMENTS PROJECT	CONTRACT NO. 1064J(R)
				74.108 55.291					DRAWN: DATE: 11/14/16 A.KIRSCH			SHEET OF SHEETS		2ND STREET SEWER REPLACEMENT STATION 22+00 TO 27+50 PLAN AND PROFILE
TABLE OF REVISIONS														FILE NO. 106.247
														REV. NO. 0