


**FIELD PRINTS**  
**CORRECTIONS AS BUILT**  
 OFFICIAL COPY  
 PREPARED BY *[Signature]*  
 SIGNED *[Signature]* CONTRACTOR

PLANS ARE TO BE RETURNED WITH  
 CORRECTIONS MADE AND CERTIFIED  
 TO IN RED INK AND DATED BY THE  
 INSPECTOR IN CHARGE UPON COMPLETION  
 OF THE WORK BEFORE FINAL PAYMENT  
 CAN BE MADE.

SIGNED *[Signature]* INSPECTOR  
 REVIEWED BY *[Signature]* RIM EL. 23.26±  
 PC/M

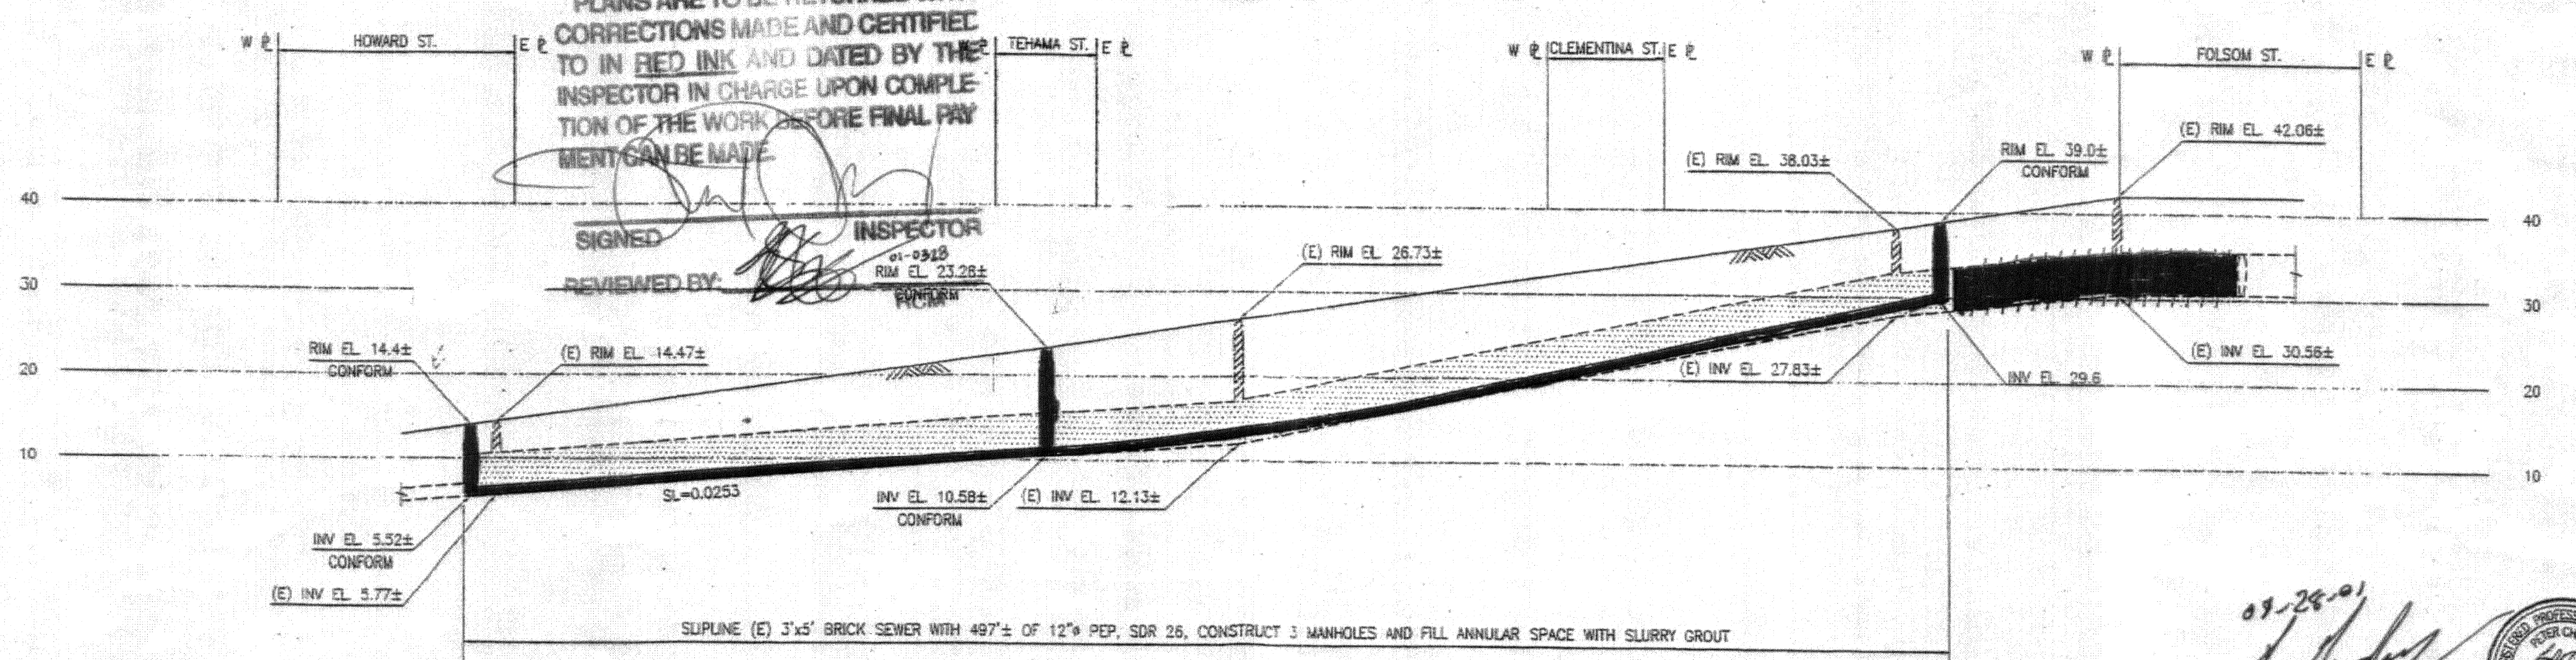

**PROFILE**  
 SCALE: HORIZ. 1"=30'  
 VERT. 1"=10'

09-28-01  
*[Signature]*




SEWER SIZED BY  
 L.L.  
 APPROVED BY  
 M.K.

NO.	DATE	DESCRIPTION	BY	APP.
TABLE OF REVISIONS				
CHECK WITH TRACING TO SEE IF YOU HAVE LATEST REVISION				
IN ASV				

REFERENCE INFORMATION  
 & FILE NO. OF SURVEYS  
 BOOK 54A PAGE 7



**UTILITIES ENGINEERING BUREAU**  
**PUBLIC UTILITIES COMMISSION**  
**CITY AND COUNTY OF SAN FRANCISCO**

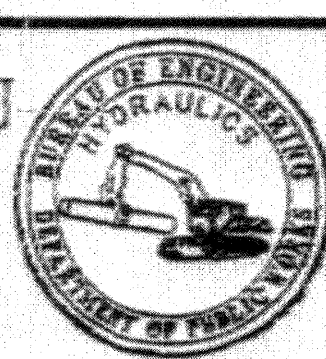

DESIGNED: DATE: 2/2000  
 DRAWN: DATE: 2/2000  
 CHECKED: DATE: 2/2000  
 PTL: 2/2000  
 APPROVED: DATE: 3/29/00  
 SECTION MANAGER: DATE: 3/29/00  
 DIVISION MANAGER: DATE: 3/29/00  
 CITY ENGINEER: DATE: 3/29/00

SCALE: AS NOTED  
 SHEET OF SHEETS: 3 OF 12

GEARY STREET AND SECOND STREET  
 SEWER REPLACEMENT  
 SECOND STREET  
 FOLSOM STREET TO HOWARD STREET  
 PLAN AND PROFILE

CONTRACT NO. CW-245  
 DRAWING NO. SW-3  
 FILE NO. 74.108  
 REV. NO.

(E) SEWER MAIN - SECOND STREET FROM HOWARD TO FOLSOM STREET  
 SCALE: NONE

**FOR REFERENCE ONLY**

REF-7