





MATCH LINE "B", STA 11+00
SEE SHEET SW-2

MATCH LINE "C", STA 16+50
SEE SHEET SW-4


SW-2 = 1
SW-6 = 1
SW-27 = 35 LF.
SW-30 = 1
SW-13 = 24 LF.

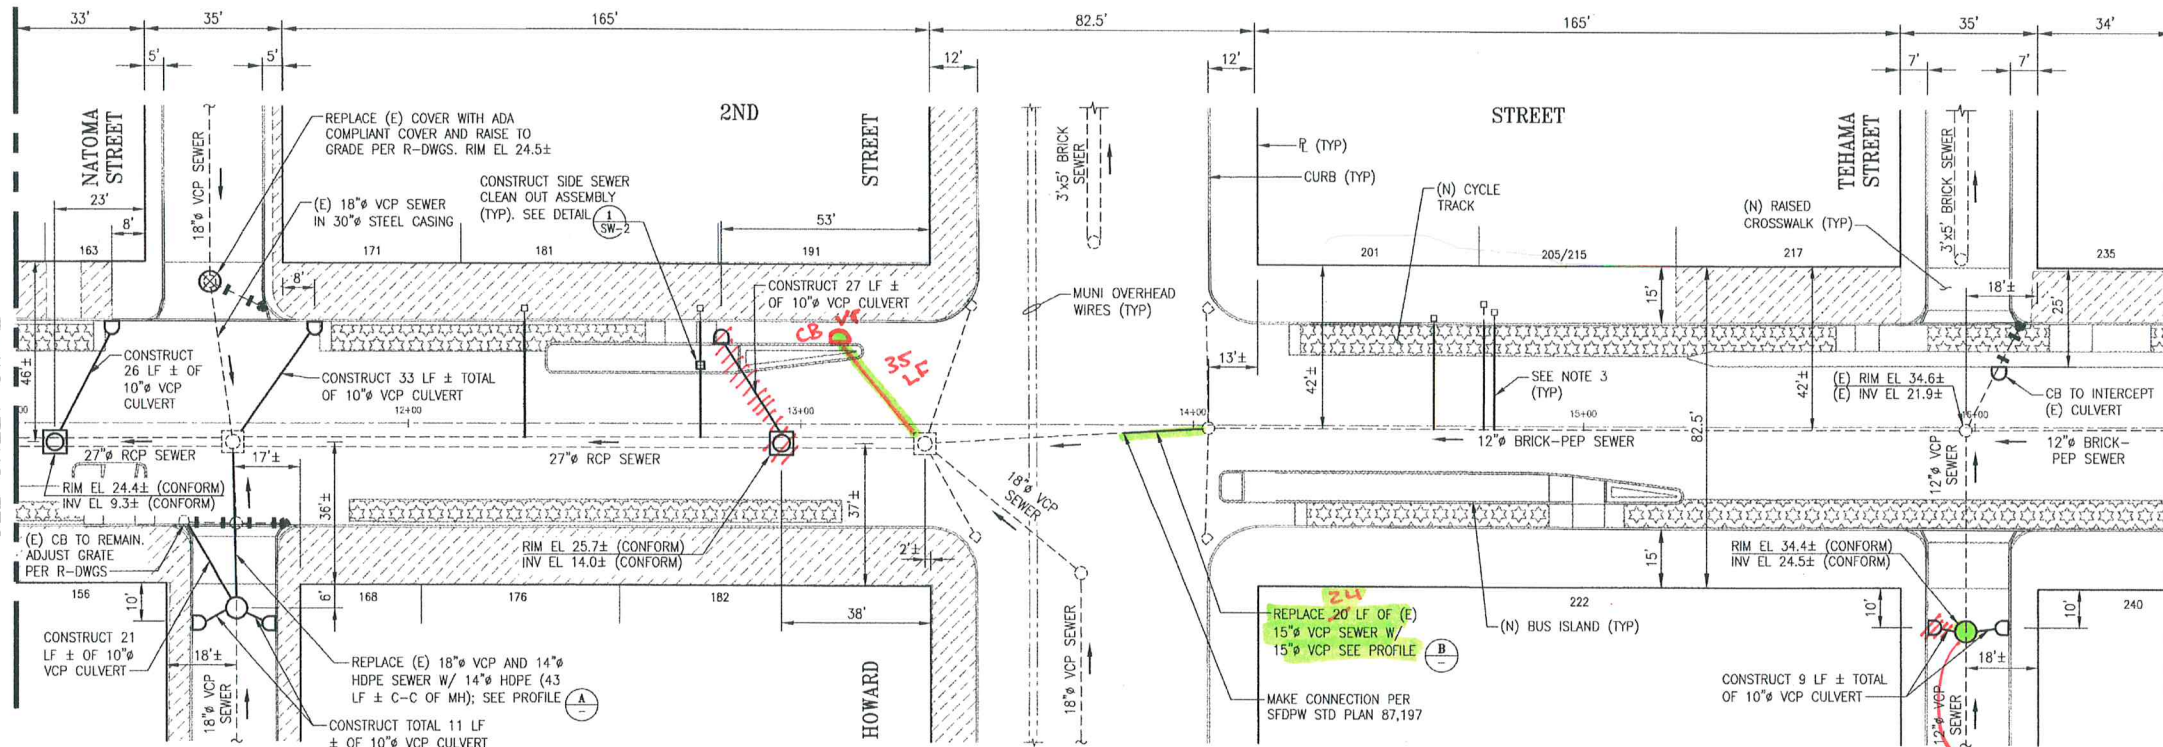

PLAN
SCALE: 1"=20'

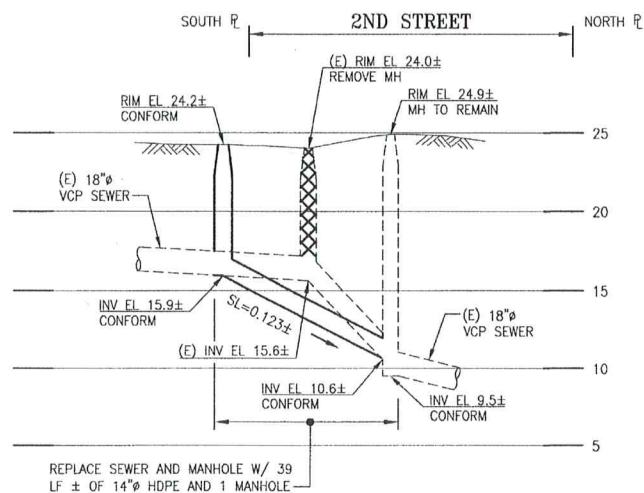

PROFILE
SCALE: HORIZ 1"=20'
VERT 1"=5'

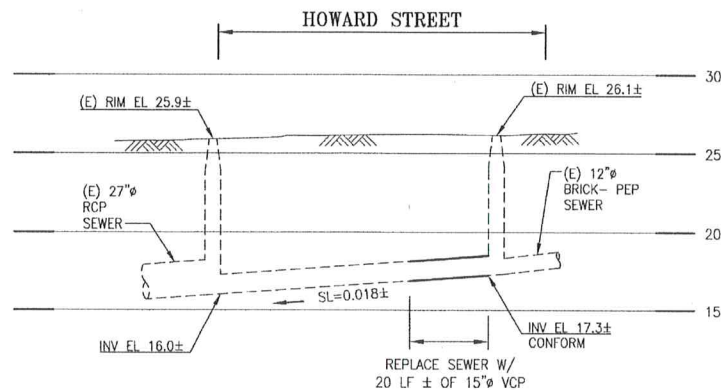

PROFILE
SCALE: HORIZ 1"=20'
VERT 1"=5'

NOTES:

- CONTRACTOR SHALL ADJUST MANHOLE FRAMES AND COVERS TO PROPOSED GRADES. REFER TO R-DWGS FOR PROPOSED ELEVATIONS.
- SEE R-DWGS FOR PROPOSED ROADWAY IMPROVEMENTS INCLUDING, BUT NOT LIMITED TO, RAISED CROSSWALKS, BUS ISLANDS, AND VARIOUS BUFFER ZONES.
- CONTRACTOR TO IDENTIFY ALL ACTIVE SIDE SEWERS WITHIN RAISED CYCLE TRACK LIMITS AND REPLACE ALL OF THEM FROM THE CURB TO THE MAIN SEWER. INVESTIGATION OF SIDE SEWERS SHALL BE COMPLETED PER CONTRACT SPECIFICATIONS PRIOR TO REPLACEMENT WORK.
- CONTRACTOR SHALL NOTIFY CITY REPRESENTATIVE IF EXISTING SIDE SEWER CONNECTIONS ARE DEFECTIVE. IF DETERMINED BY CITY REPRESENTATIVE THAT THE CONNECTION REQUIRES REPLACEMENT, SIDE SEWER CONNECTION TO RC SEWERS/RCP/BRICK SHALL BE CONSTRUCTED PER DETAILS ON SW-4. SIDE SEWER CONNECTIONS TO VCP SHALL BE PER CONTRACT SPECIFICATIONS. CITY REPRESENTATIVE MAY ALSO REQUIRE CONTRACTOR TO LINE (E) SIDE SEWERS WITH CIPL.



ELEVATION DATUM SFVD13	SEWER SIZED BY B.A. <i>BA</i>
	APPROVED BY B.S. <i>BS</i>

NO.	DATE	ISSUED FOR BIDS	DESCRIPTION	AS BY	LW APP.
0	10/16	ISSUED FOR BIDS		AS	LW
TABLE OF REVISIONS					

REFERENCE INFORMATION
& FILE NO. OF SURVEYS
64,917
74,108



DESIGN & ENGINEERING
CITY & COUNTY OF SAN FRANCISCO
SAN FRANCISCO PUBLIC WORKS
30 VAN NESS AVENUE, 5TH FLOOR
SAN FRANCISCO, CA 94102 - 6028

Section Mgr: *Lesley Wong*
Deputy Division Mgr: *Iqbal Dhapa*
Division Mgr: *Patrick Rivera*

Date: *11/16*
DESIGNED: DATE: *J.K./A.S. 11/2016*
DRAWN: DATE: *A.KIRSCH 11/2016*
CHECKED: DATE: *G.FONG 11/2016*



SCALE:
AS NOTED
SHEET OF SHEETS

2ND STREET STREETSCAPE
IMPROVEMENTS PROJECT

2ND STREET SEWER REPLACEMENT
STATION 11+00 TO 16+50
PLAN AND PROFILES

CONTRACT NO.
1064J(R)
DRAWING NO.
SW-3
FILE NO.
106,245
REV. NO.
0