



PP #9

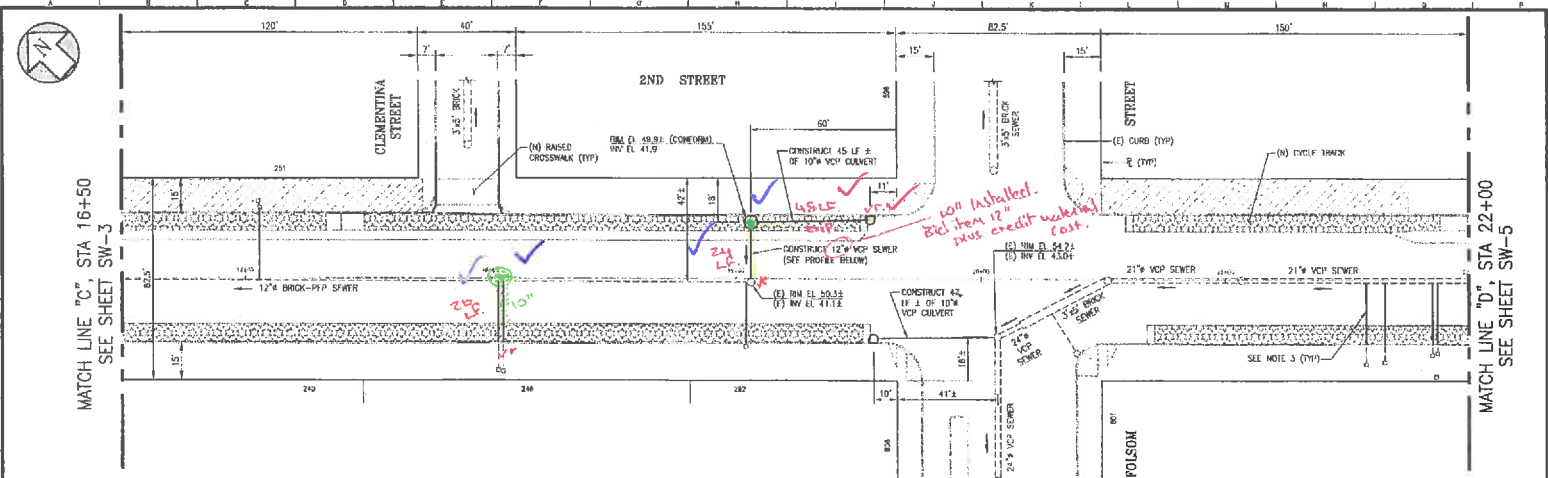

- (1) MH x
- 26 LF of 60" VCP x
- 24 LF of 60" VCP x
- 48 LF of DIP x
- (1) MH x
- (1) CB x

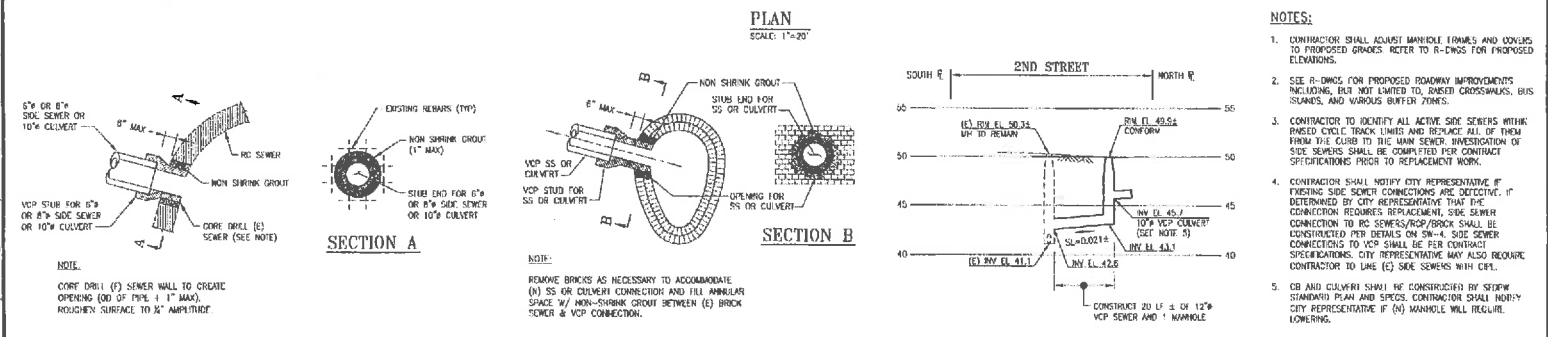

SS OR CULVERT CONNECTION FOR 42" Ø RC SEWERS OR GREATER

SCALE: NONE

1

SS OR CULVERT CONNECTION DETAIL FOR BRICK SEWERS

SCALE: NONE

2

PROFILE

SCALE: HORIZ 1"=20' VERT 1"=5'

21' 0" 20' 40' 5' 0" 5' 10'

HORIZONTAL SCALE: 1"=20' VERTICAL SCALE: 1"=5'

NOTES:

- CONTRACTOR SHALL ADJUST MANHOLE FRAMES AND COVERS TO PROPOSED GRADES. REFER TO R-DIMS FOR PROPOSED ELEVATIONS.
- SEE R-DIMS FOR PROPOSED ROADWAY IMPROVEMENTS INCLUDING, BUT NOT LIMITED TO, RASSED CROSSWALKS, BUS ISLANDS, AND VARIOUS BUFFER ZONES.
- CONTRACTOR TO IDENTIFY ALL ACTIVE SIDE SEWERS WITHIN PROPOSED CYCLE TRACK LINES AND REPLACE ALL OF THEM FROM THE CURB TO THE MAIN SEWER. INVESTIGATION OF SIDE SEWERS SHALL BE COMPLETED PER CONTRACT SPECIFICATIONS PRIOR TO REPLACEMENT WORK.
- CONTRACTOR SHALL NOTIFY CITY REPRESENTATIVE IF EXISTING SIDE SEWER CONNECTIONS ARE DETECTIVE. IF DETERMINED BY CITY REPRESENTATIVE THAT THE CONNECTION REQUIRES REPLACEMENT, SIDE SEWER CONNECTION TO RC SEWERS/RCP/BRICK SHALL BE CONSTRUCTED PER DETAILS ON SW-4. SIDE SEWER CONNECTIONS TO VCP SHALL BE PER CONTRACT SPECIFICATIONS. CITY REPRESENTATIVE MAY ALSO REQUEST CONTRACTOR TO LINE (C) SIDE SEWERS WITH CPT.
- CB AND CULVERT SHALL BE CONSTRUCTED BY SEWER STANDARD PLAN AND SPEC. CONTRACTOR SHALL NOTIFY CITY REPRESENTATIVE IF (N) MANHOLE WILL REQUIRE LOWERING.

ELEVATION DATUM

SPV013

REFERENCE INFORMATION

FILE NO. OF SURVEY

74108

DESIGN & ENGINEERING

SAINT FRANCISCO PUBLIC WORKS

3000 NEWMARKET AVENUE

SAN FRANCISCO, CA 94108

DESIGNER

J.R. / A.S. 11/2016

CHECKER

A.J. / J.C. 11/2016

DATE

11/2016

CONTRACT NO.

10641(P)

SW-4

FILE NO.

10641(P)

REV. NO.

0

2ND STREET STREETSCAPE IMPROVEMENTS PROJECT

2ND STREET SEWER REPLACEMENT

STATION 16+50 TO 22+00

PLAN AND DETAILS

CITY JOB ORDER NO. 28551