


MATCH LINE B-B  
SEE DRAWING WD 2808-2 FOR CONTINUATION

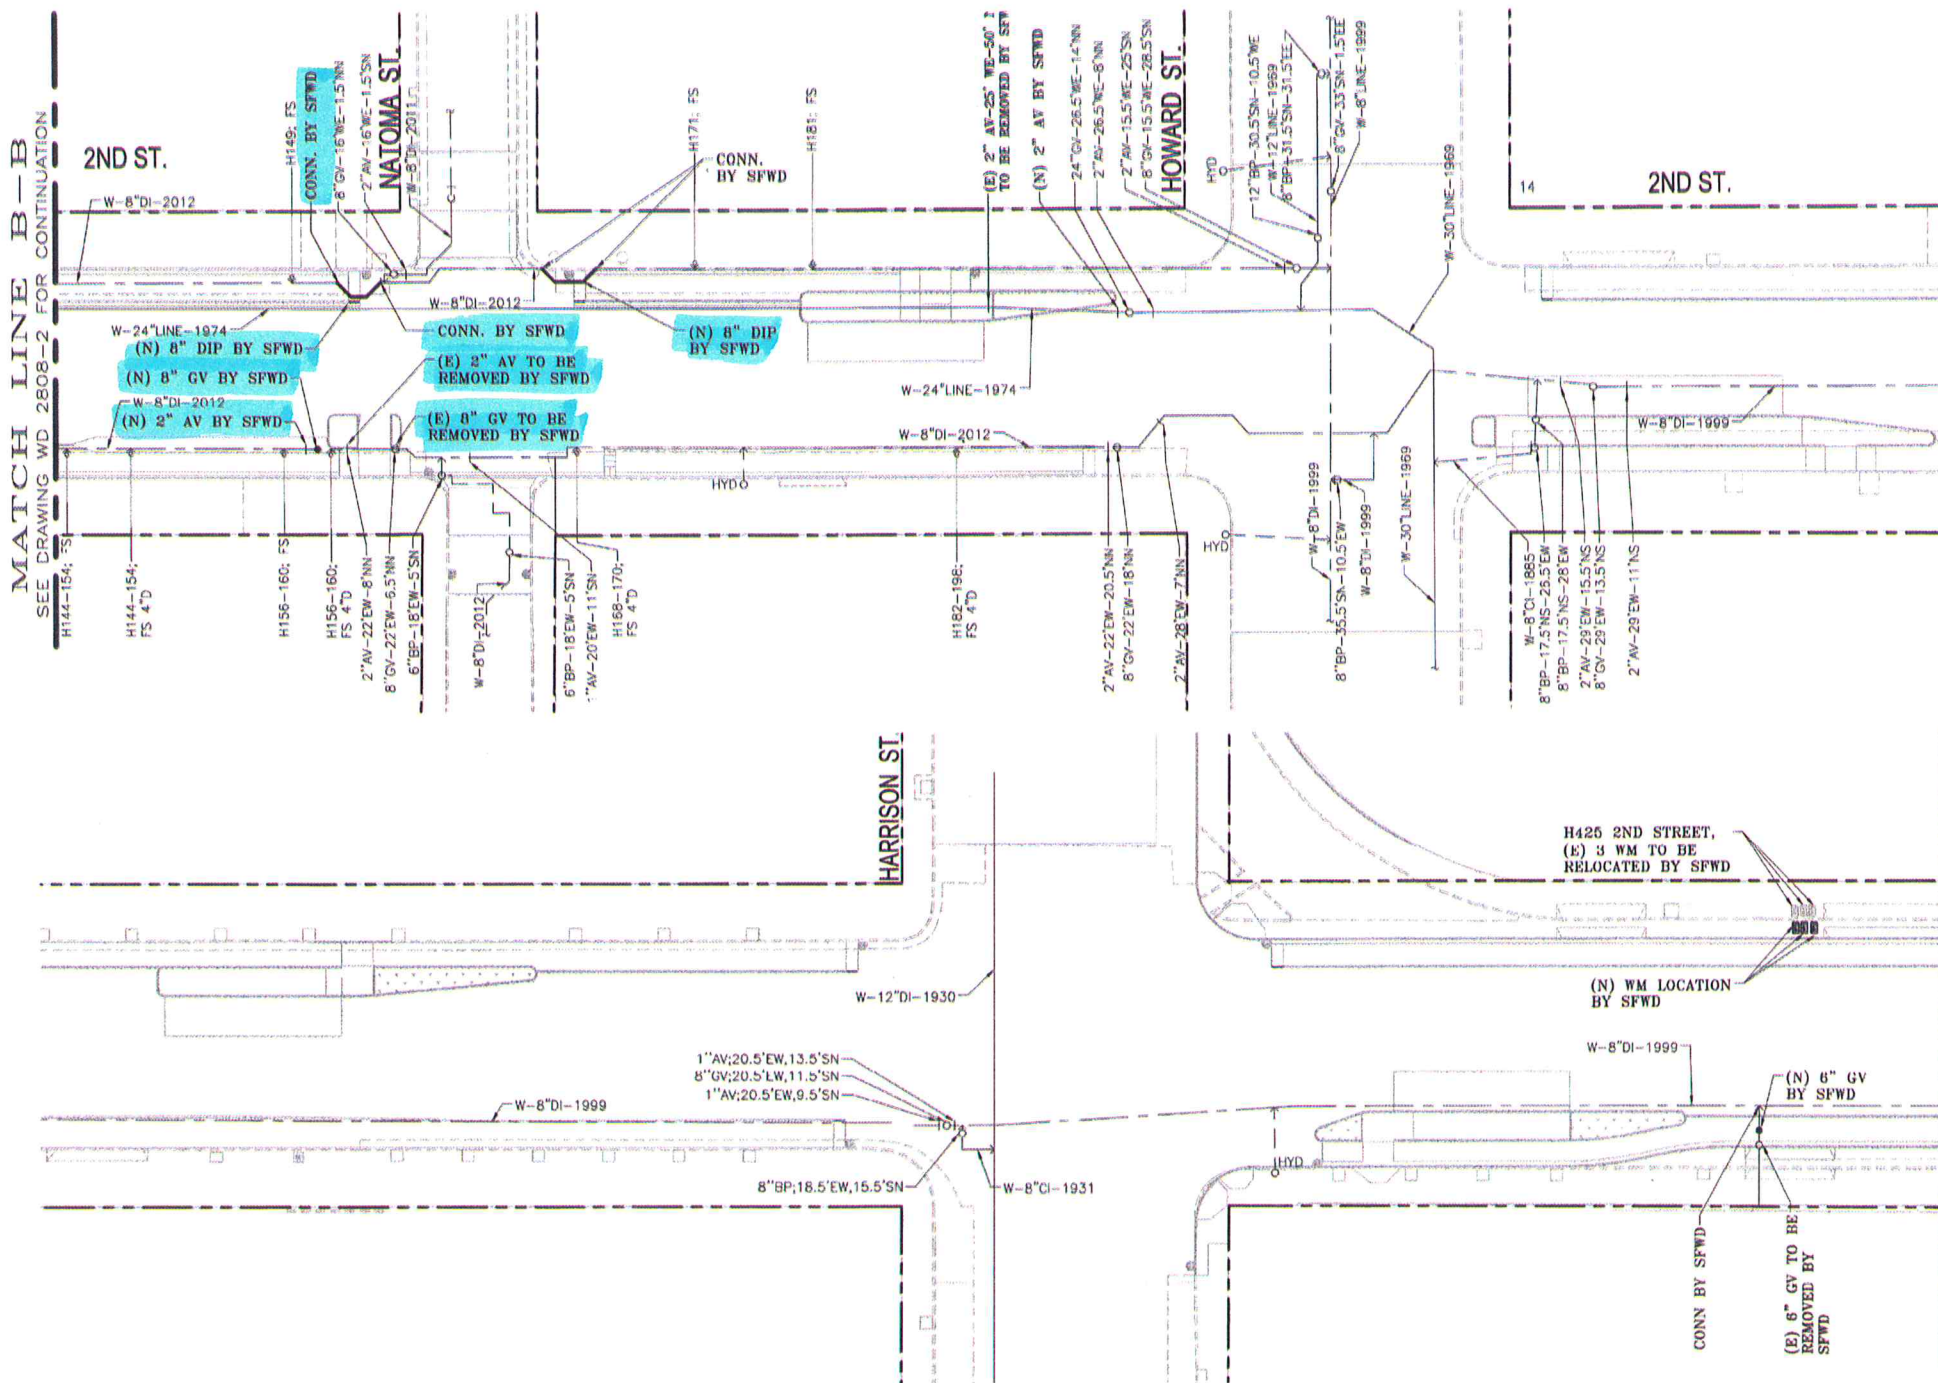

- NOTE:**
- 1. FOR FIRE SERVICE VALVES LOCATED ON BUS STOP ISLANDS, USE SIDEWALK COVERS. CONTACT CDD ENGINEERING FOR DETAILS.
  - 2. SEE NOTE NO. 2 ON WD-2808-2

MATCH LINE C-C  
SEE DRAWING WD 2808-4 FOR CONTINUATION

2/27/8  
SIGNED: *[Signature]*  
**M2 AS BUILT**

PLOT: EXTEND  
SCALE: 1:1  
BORDER:  
22.34  
COLOR: No.  
RED 0.70MM  
YELLOW 0.20MM  
GREEN 0.25MM  
CYAN 0.40MM  
BLUE 0.50MM  
MAGENTA 0.20MM  
WHITE 0.35MM  
GRAY 0.15MM  
9 0.15MM  
10 1.00MM  
100 0.70MM  
210 0.60MM

FOR UTILITY OCCUPANCY DRAWING  
SEE SHEET U-3



FOR THE SOLE USE OF THE DOCUMENT RECIPIENT  
- DO NOT CITE, COPY, OR CIRCULATE WITHOUT  
THE EXPRESSED PERMISSION OF THE SFPUC.

**REFERENCES**  
GATE BOOK PAGES, PLANS,  
SURVEY NOTES, ETC., USED  
  
GATE BOOK PAGES  
NO. 112,115  
  
SFVD13  
SFCS13



NO.	DATE	DESCRIPTION	BY	APPROVED

CONTRACT NO. 1064J (R) WATER DEPT. NO. WD-2808 (R)		
CITY AND COUNTY OF SAN FRANCISCO <b>PUBLIC UTILITIES COMMISSION</b> INFRASTRUCTURE DIVISION ENGINEERING MANAGEMENT BUREAU		
2ND STREET IMPROVEMENT PROJECT		
24-INCH DIP WATER MAIN REPLACEMENT ON 2ND & HOWARD STREETS & RELOCATION OF WATER PIPE APPURTENANCES		
CHECKED / APPROVED <i>[Signature]</i>	DRAWN <i>[Signature]</i>	SCALE AS SHOWN
SECTION MANAGER <i>[Signature]</i>	DESIGNED <i>[Signature]</i>	DATE OCT 2016
APPROVED <i>[Signature]</i>	MANAGER, ENGINEERING MANAGEMENT BUREAU <i>[Signature]</i>	MANAGER, CITY UTILITIES DIVISION <i>[Signature]</i>
SHEET OF	PLAN NO. WD-2808-3	REVISION NO. E-30113
REVISIONS		0