


TRAFFIC CONTROL PLAN
1084J - 2ND ST IMPROVEMENTS PROJECT
ELECTRICAL WORK PLAN - 2ND ST AT HARRISON ST

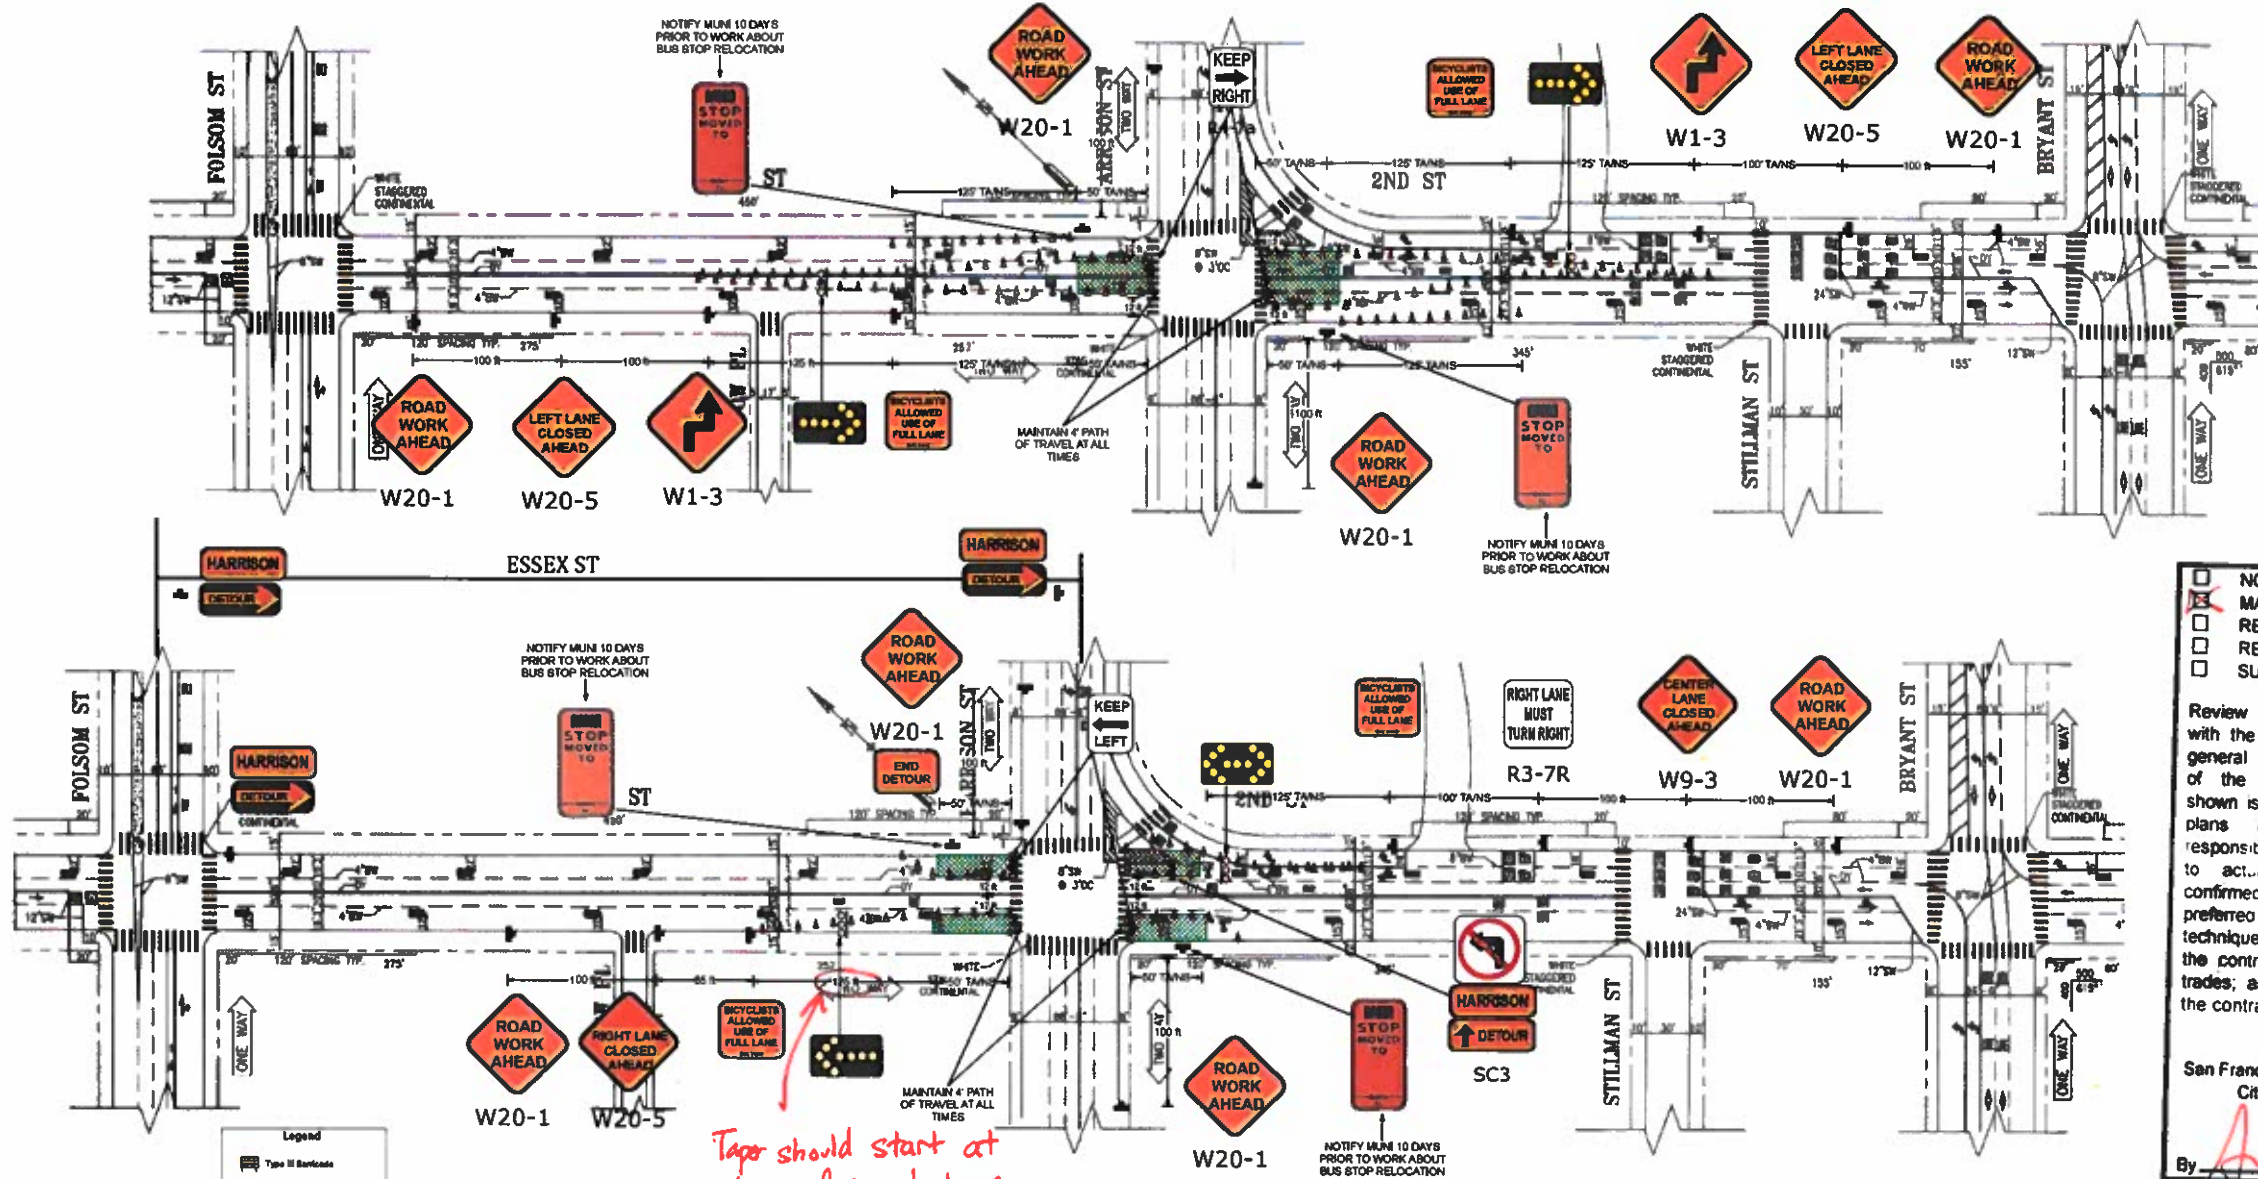

☐ NO EXCEPTIONS TAKEN
☒ MAKE CORRECTIONS NOTED
☐ REJECTED
☐ REVISE AND RESUBMIT
☐ SUBMIT SPECIFIED ITEM(S)

Review is only for general conformance with the design concept of the project and general compliance with the requirements of the contract documents. Any action shown is subject to the requirements of the plans and specifications. Contractor's responsibilities include, but are not limited to, actual dimensions which shall be confirmed and correlated at the job site; preferred fabrication processes and techniques of construction; coordination of the contractor's work with that of all other trades; and the satisfactory performance of the contractor's work.

Sustainable Streets Division
San Francisco Municipal Transportation Agency
City and County of San Francisco

By *[Signature]* Date *2/19/2019*

- Legend**
- Type II Barricade
 - 24" Traffic Cone
 - Work Area
 - Sign and Stand
 - Direction of Travel
 - Type III Barricade (Plan View)
 - ADA Pedestrian Barricade
 - Not To Scale
 - One-Way/No Stoppage
 - Police Officer
 - Flagger
 - Type I Barricade
 - Down Work Truck
 - Pipe to be Installed
 - Drilling Utility
 - Flashing Beacon



Plan Scale
1" = 50'

*Taper should start at edge of travel lane.
Follow CA-MUTCD for transition lengths.*

STREET	TIME	NORTHBOUND	SOUTHBOUND	EASTBOUND	WESTBOUND
2nd STREET					
Main St to Brannan St (M-C)	10:00 AM - 4:00 PM (M-F)	10:12	10:12	-	-
	10:00 AM - 6:00 PM (S/B)	10:12	10:12	-	-
	At Other Times	Full Roadway	Full Roadway	-	-
Cross Streets for 2nd Street					
Harrison St (M-C)	10:00 AM - 4:00 PM (M-F)	-	-	20:10	20:10
	10:00 AM - 6:00 PM (S/B)	-	-	20:10	20:10
	At Other Times	-	-	Full Roadway	Full Roadway

CMC
Traffic Control Specialists

3450 3rd St, Suite 3G, San Francisco, CA 94114
Phone: (415) 208-1700 Fax: (415) 208-1711
Contractor License No. 792059 (Class A & C-31)

Date: 02/08/2019 Author: PMRC Project: 1084J
Client: M2 Owner: SFPD Location: SAN FRANCISCO
TCP: 076 CMC Job #: 1430 REV: 1

Comments:

- 1) WORK HOURS:
- 2) ELECTRICAL RELATED WORK IS LIMITED TO ONE BLOCK AND ONE ADJACENT INTERSECTION AT ANY ONE TIME.
- 3) THE CONTRACTOR SHALL NOT PREVENT OR DELAY THE OPERATION OF MASS TRANSIT VEHICLE AT ANY TIME.