



1064J - PP#7 AS BUILT.

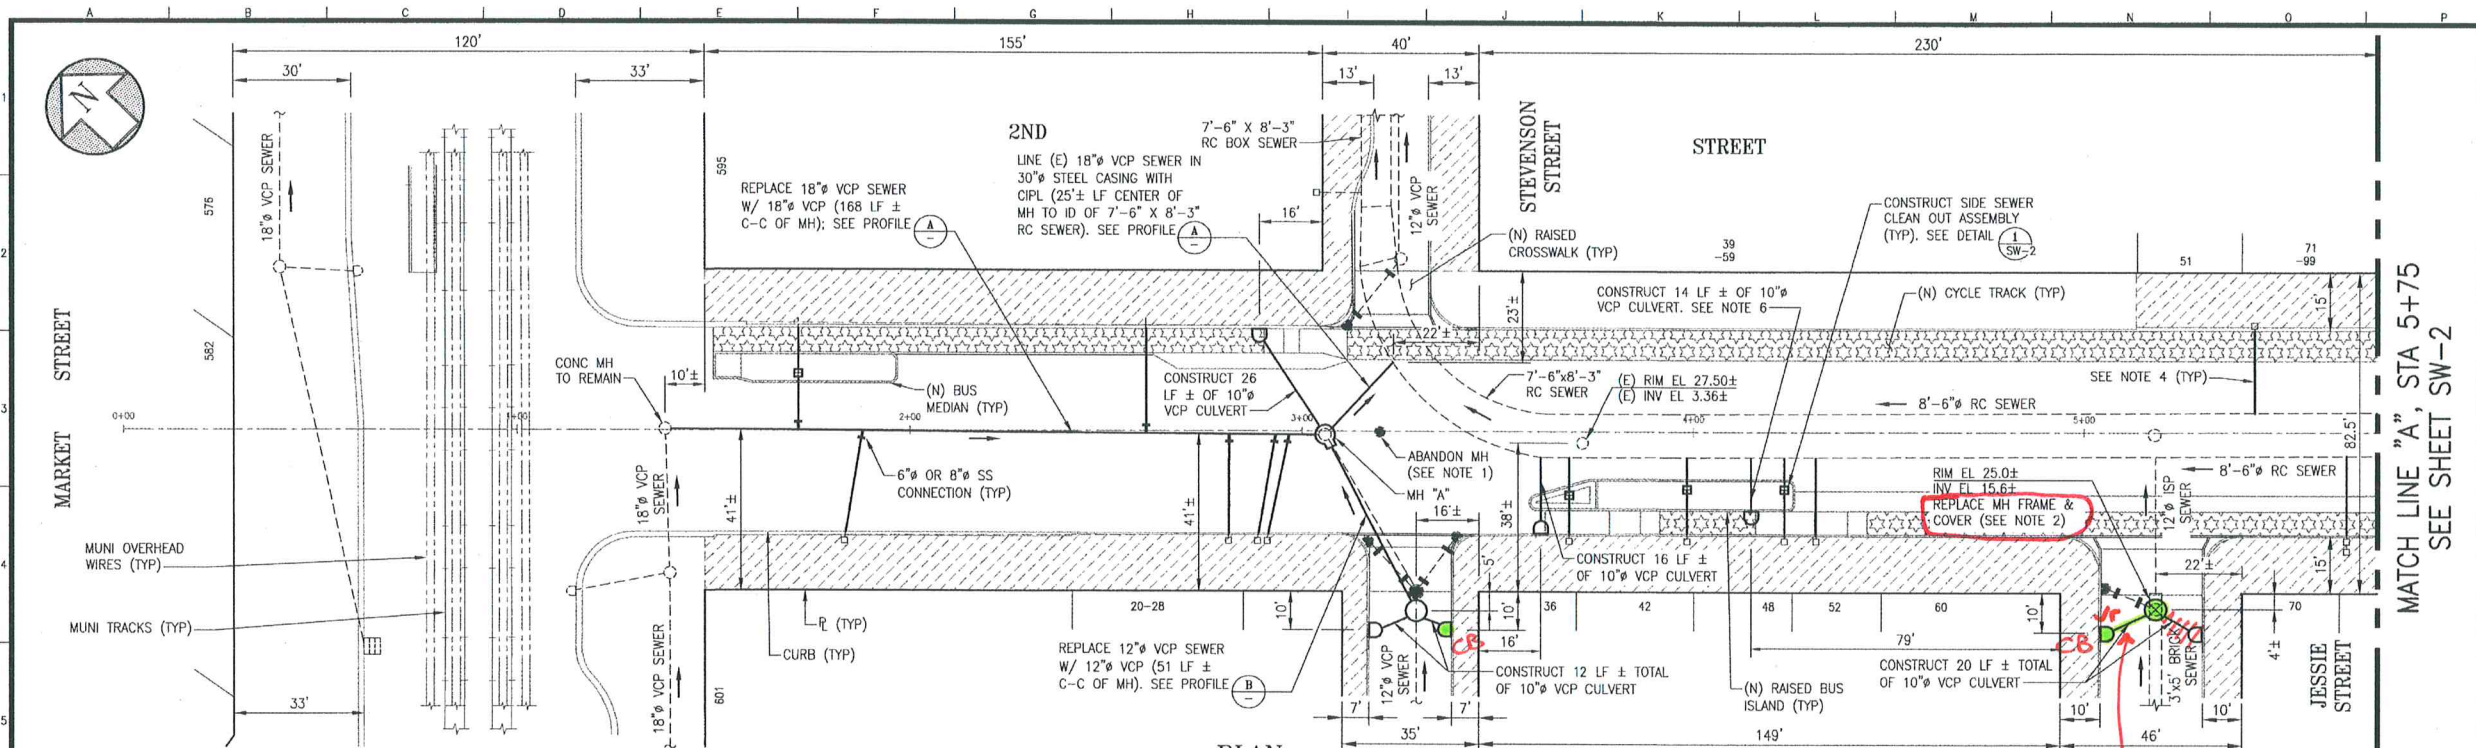

- NOTES:**
1. CONTRACTOR TO ABANDON INACTIVE MH PER DPW STANDARD SPECIFICATIONS.
  2. CONTRACTOR SHALL ADJUST MANHOLE FRAMES AND COVERS TO PROPOSED GRADES. REFER TO R-DWGS FOR PROPOSED ELEVATIONS.
  3. SEE R-DWGS FOR PROPOSED ROADWAY IMPROVEMENTS INCLUDING, BUT NOT LIMITED TO, RAISED CROSSWALKS, BUS ISLANDS, AND VARIOUS BUFFER ZONES.
  4. CONTRACTOR TO IDENTIFY ALL ACTIVE SIDE SEWERS WITHIN RAISED CYCLE TRACK LIMITS AND REPLACE ALL OF THEM FROM THE CURB TO THE MAIN SEWER. INVESTIGATION OF SIDE SEWERS SHALL BE COMPLETED PER CONTRACT SPECIFICATIONS PRIOR TO REPLACEMENT WORK.
  5. CONTRACTOR SHALL NOTIFY CITY REPRESENTATIVE IF EXISTING SIDE SEWER CONNECTIONS ARE DEFECTIVE. IF DETERMINED BY CITY REPRESENTATIVE THAT THE CONNECTION REQUIRES REPLACEMENT, SIDE SEWER CONNECTION TO RC SEWERS/RCP/BRICK SHALL BE CONSTRUCTED PER DETAILS ON SW-4. SIDE SEWER CONNECTIONS TO VCP SHALL BE PER CONTRACT SPECIFICATIONS. CITY REPRESENTATIVE MAY ALSO REQUIRE CONTRACTOR TO LINE (E) SIDE SEWERS WITH CIPL.
  6. CONTRACTOR SHALL LAYOUT CB AND NEW AWSS LINE PRIOR TO CONSTRUCTION TO CONFIRM CLEARANCE BETWEEN CB AND AWSS LINE. IF LESS THAN 2-FT CLEARANCE, ADJUST OR DELETE CB PER CITY REPRESENTATIVE'S DIRECTION.

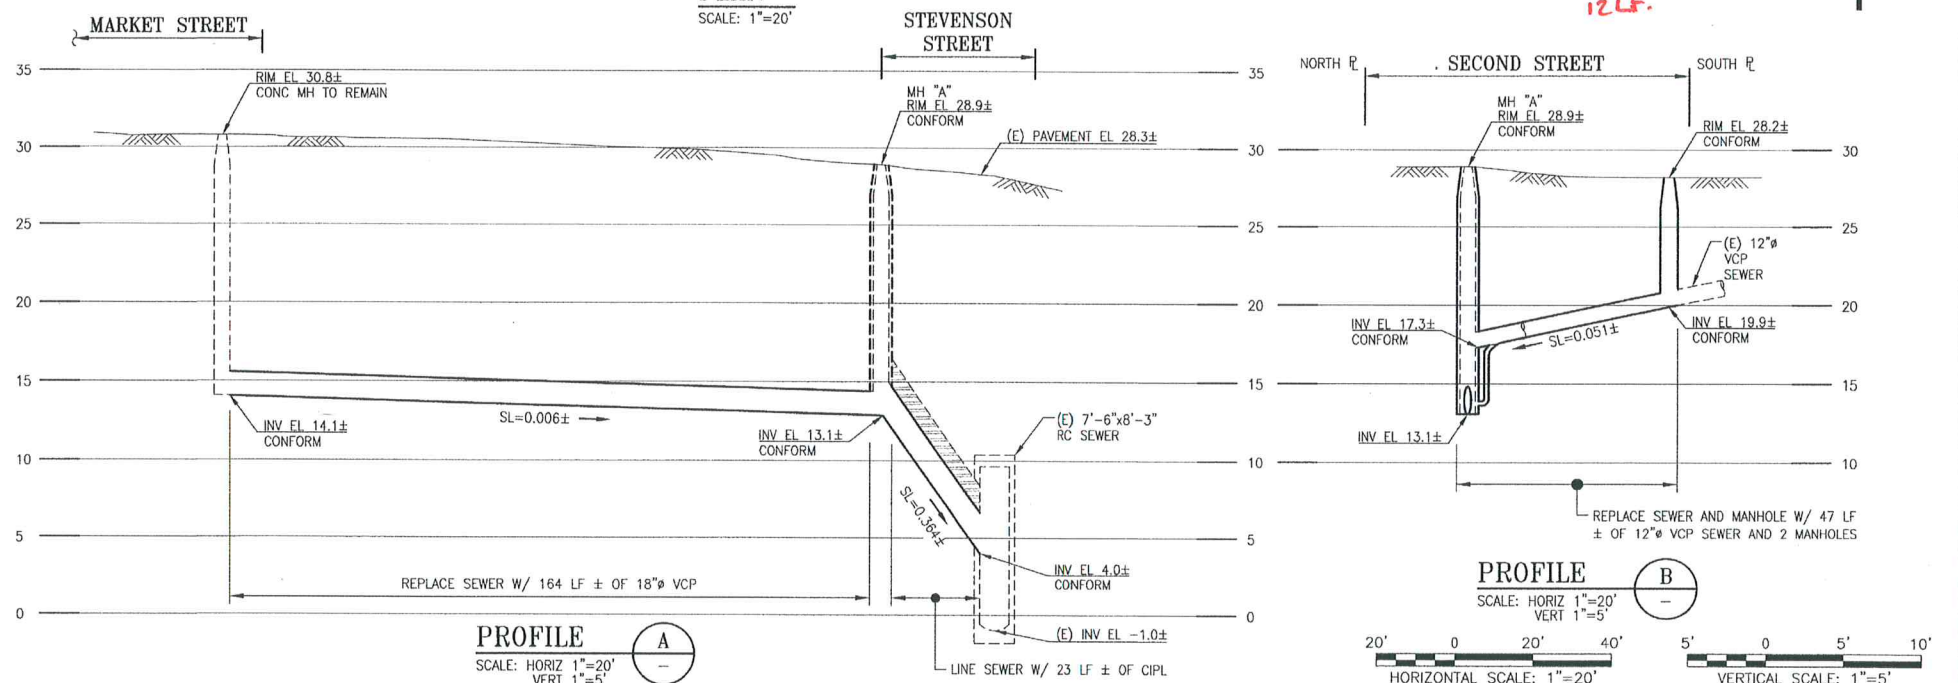

ELEVATION DATUM	SEWER SIZED BY
SFVD13	B.A. <i>BA</i>
	APPROVED BY
	B.S. <i>BS</i>

NO.	DATE	DESCRIPTION	BY	APP.
0	10/16	ISSUED FOR BIDS	AS	LW

REFERENCE INFORMATION & FILE NO. OF SURVEYS
50,158
55,281.7
55,279



**DESIGN & ENGINEERING**  
CITY & COUNTY OF SAN FRANCISCO  
SAN FRANCISCO PUBLIC WORKS  
30 VAN NESS AVENUE, 5TH FLOOR  
SAN FRANCISCO, CA 94102 - 6028

Section Mgr:	LESLEY WONG	Date:	11/9/16
Drawn:	IOBAL DHAPA	Date:	11/14/16
Checked:	PATRICK RIVERA	Date:	11/17/16
Designed:	J.K./A.S.	Date:	11/10/16
Drawn:	A.KIRSCH	Date:	11/10/16
Checked:	G.FONG	Date:	11/10/16



SHEET OF SHEETS
AS NOTED

**2ND STREET STREETSCAPE IMPROVEMENTS PROJECT**  
**2ND STREET SEWER REPLACEMENT**  
STATION 0+00 TO 5+75  
PLAN AND PROFILES

CONTRACT NO.	1064J(R)
DRAWING NO.	SW-1
FILE NO.	106.243
REV. NO.	0

SW-3 = 1  
SW-6 = 2.  
SW-27 = 12LF.  
SW-30 = 1