


MATCH LINE "A", STA 5+75
SEE SHEET SW-1

MATCH LINE "B", STA 11+00
SEE SHEET SW-3


SW-3=1
SW-6=1
SW-27=8LF.
SW-30=1

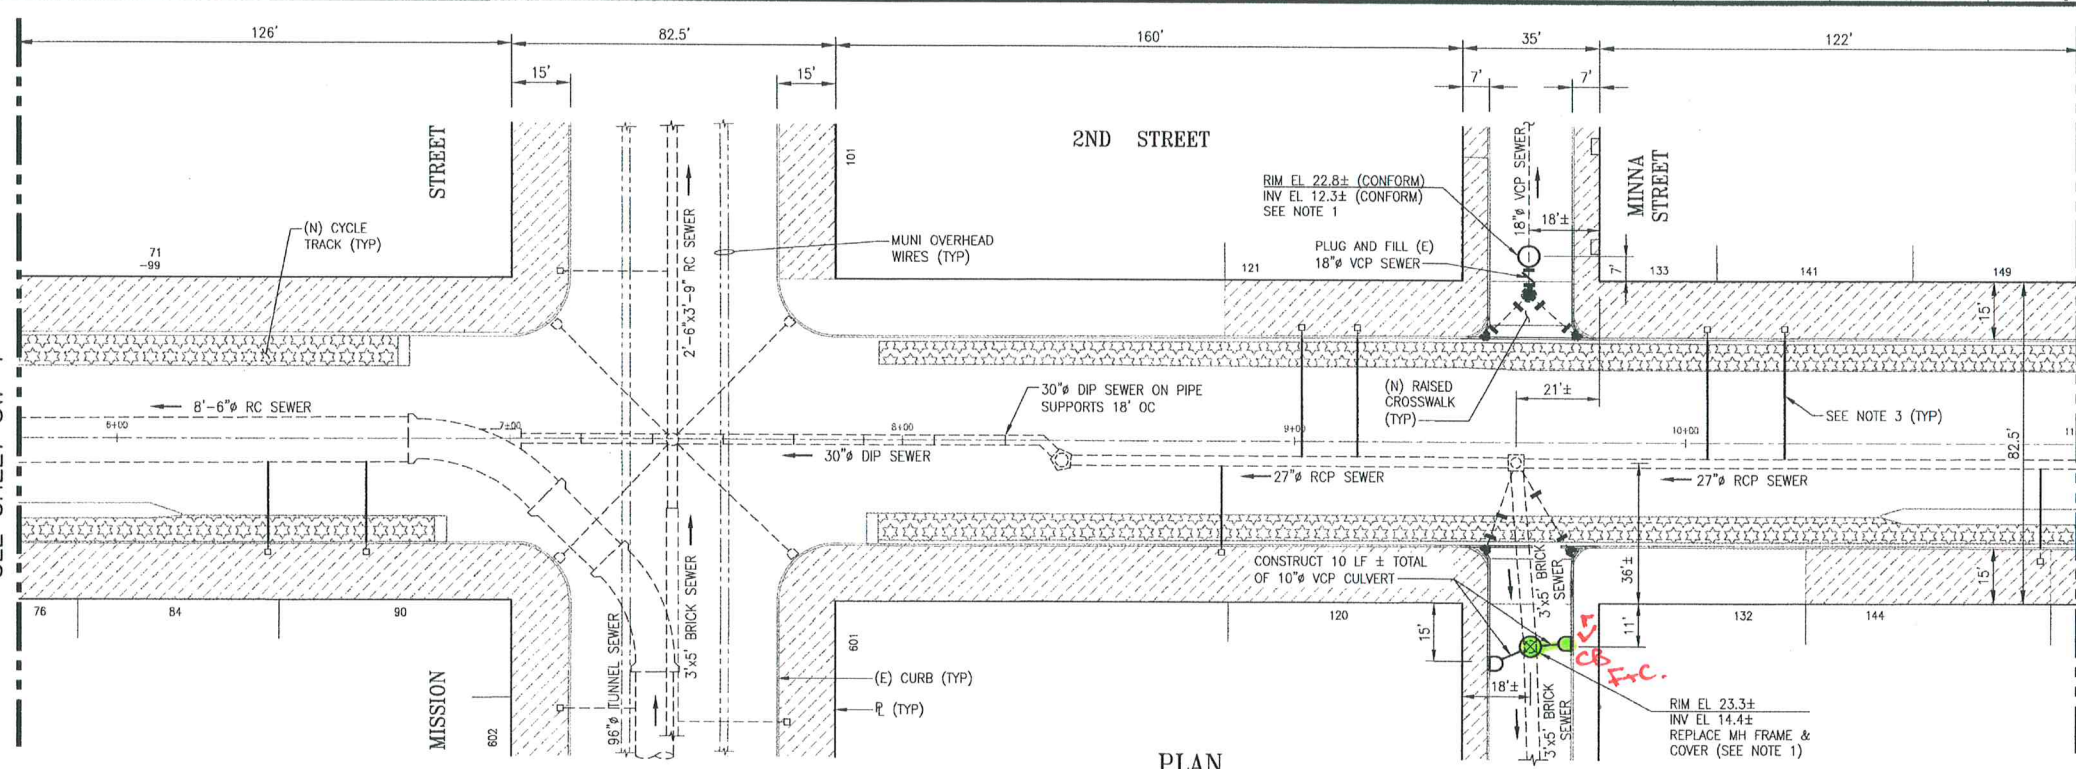


PLAN
SCALE: 1"=20'

NOTES:

1. CONTRACTOR SHALL ADJUST MANHOLE FRAMES AND COVERS TO PROPOSED GRADES. REFER TO R-DWGS FOR PROPOSED ELEVATIONS.
2. SEE R-DWGS FOR PROPOSED ROADWAY IMPROVEMENTS INCLUDING, BUT NOT LIMITED TO, RAISED CROSSWALKS, BUS ISLANDS, AND VARIOUS BUFFER ZONES.
3. CONTRACTOR TO IDENTIFY ALL ACTIVE SIDE SEWERS WITHIN RAISED CYCLE TRACK LIMITS AND REPLACE ALL OF THEM FROM THE CURB TO THE MAIN SEWER. INVESTIGATION OF SIDE SEWERS SHALL BE COMPLETED PER CONTRACT SPECIFICATIONS PRIOR TO REPLACEMENT WORK.
4. CONTRACTOR SHALL NOTIFY CITY REPRESENTATIVE IF EXISTING SIDE SEWER CONNECTIONS ARE DEFECTIVE. IF DETERMINED BY CITY REPRESENTATIVE THAT THE CONNECTION REQUIRES REPLACEMENT, SIDE SEWER CONNECTION TO RC SEWERS/RCP/BRICK SHALL BE CONSTRUCTED PER DETAILS ON SW-4. SIDE SEWER CONNECTIONS TO VCP SHALL BE PER CONTRACT SPECIFICATIONS. CITY REPRESENTATIVE MAY ALSO REQUIRE CONTRACTOR TO LINE (E) SIDE SEWERS WITH CIPL.

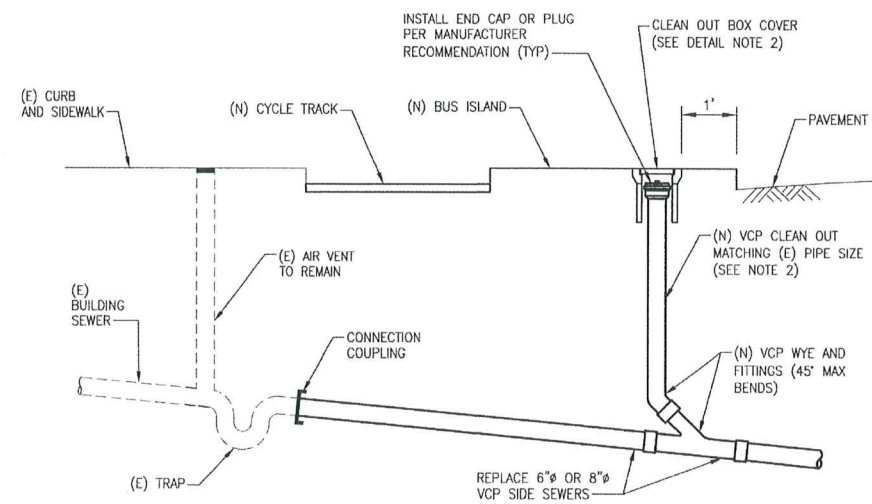

SIDE SEWER CLEAN OUT
ASSEMBLY AT (N) BUS ISLAND
SCALE: NONE

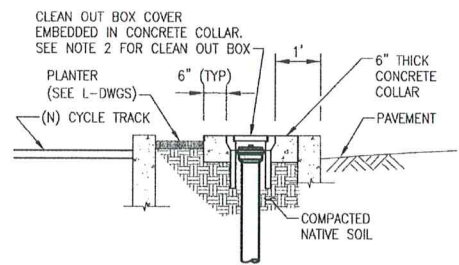

CLEAN OUT COVER AT PLANTER

DETAIL NOTES:

1. REFER TO SFDPM STD PLAN 87,196 FOR ALL OTHER DETAILS.
2. CLEAN OUT BOX COVER SHALL HAVE LOCKING CAST IRON LID PER MANUFACTURER'S RECOMMENDATIONS. INSTALL ADA HEEL PROOF COVER FLUSH WITH GRADE. TEXT ON COVER SHALL BE "SEWER CO." BOX AND LID SHALL BE CHRISTY PRODUCTS OR APPROVED EQUAL.
3. AT LOCATIONS WITH PLANTING, FRESH AIR INLET SHALL HAVE 6" CONC COLLAR AND SHALL BE SET FLUSH W/ NEW CURB. CONC COLLAR SHALL BE EMBEDDED 6" INTO PLANTING MEDIA.

20' 0 20' 40'
HORIZONTAL SCALE: 1"=20'

5' 0 5' 10'
VERTICAL SCALE: 1"=5'

ELEVATION
DATUM
SFVD13

NO.	DATE	DESCRIPTION	BY	APP.
0	10/16	ISSUED FOR BIDS	AS	LW

REFERENCE INFORMATION & FILE NO. OF SURVEYS
50,158 55,281.7 55,279



DESIGN & ENGINEERING
CITY & COUNTY OF SAN FRANCISCO
SAN FRANCISCO PUBLIC WORKS
30 VAN NESS AVENUE, 6TH FLOOR
SAN FRANCISCO, CA 94102 - 6028

Section Mgr. LESLEY WONG	Date: 11/9/16
Deputy Division Mgr. IQBAL DHAPA	Date: 11/14/16
Division Mgr. PATRICK RIVERA	Date: 11/15/16

DESIGNED: J.K./A.S.	DATE: 11/20/16
DRAWN: A.KIRSCH	DATE: 11/20/16
CHECKED: G.FONG	DATE: 11/20/16



SCALE: AS NOTED
SHEET OF SHEETS

2ND STREET STREETScape
IMPROVEMENTS PROJECT
2ND STREET SEWER REPLACEMENT
STATION 5+75 TO 11+00
PLAN AND DETAIL

CONTRACT NO. 1064J(R)
DRAWING NO. SW-2
FILE NO. 106,244
REV. NO. 0