


TRAFFIC CONTROL PLAN
1064J - 2ND ST IMPROVEMENTS PROJECT
ISLAND WORK PLAN - 2ND ST FROM BRYANT ST TO BRANNAN ST

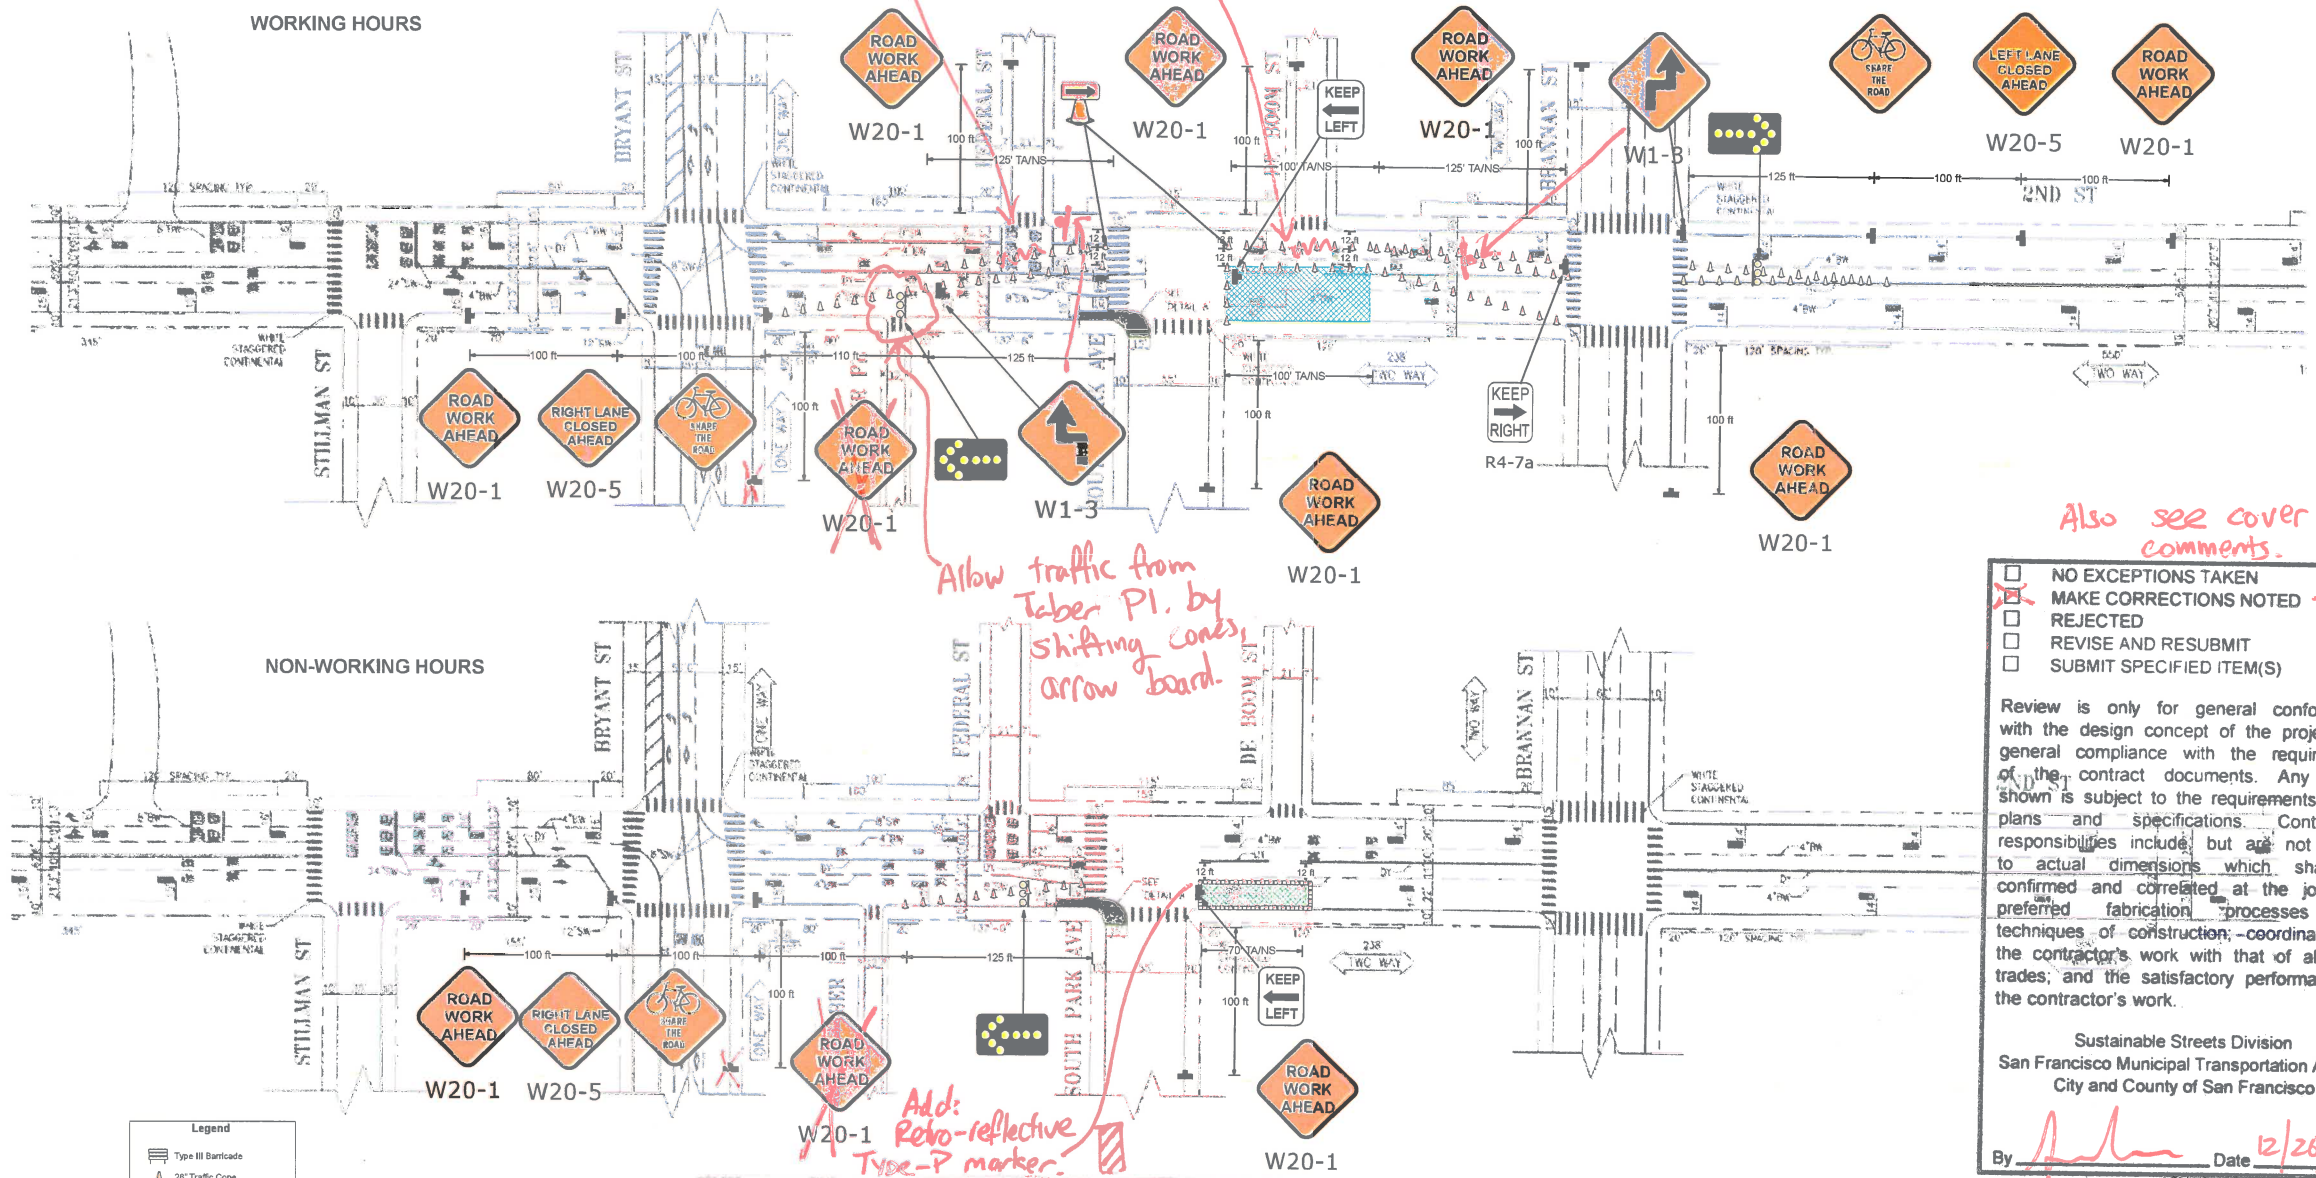

Also see cover page comments.


- ☐ NO EXCEPTIONS TAKEN
- ☒ MAKE CORRECTIONS NOTED
- ☐ REJECTED
- ☐ REVISE AND RESUBMIT
- ☐ SUBMIT SPECIFIED ITEM(S)

Review is only for general conformance with the design concept of the project and general compliance with the requirements of the contract documents. Any action shown is subject to the requirements of the plans and specifications. Contractor's responsibilities include, but are not limited to actual dimensions which shall be confirmed and corrected at the job site; preferred fabrication processes and techniques of construction; coordination of the contractor's work with that of all other trades; and the satisfactory performance of the contractor's work.

Sustainable Streets Division
San Francisco Municipal Transportation Agency
City and County of San Francisco

By Date 12/26/2018

- Legend
- Type III Barricade
 - 28" Traffic Cone
 - Work Area
 - Sign and Stand
 - Direction of Travel
 - Type III Barricade (Plain View)
 - ADA Pedestrian Barricades
 - NTS Not To Scale
 - TANS Turn-Away/No Stopping
 - Police Officer
 - Flagger
 - Type I Barricade
 - Work Truck
 - Pipe to be Installed
 - Existing Utility
 - Flashing Beacon

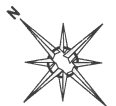

Plan Scale
1" = 50'

STREET	TIME	LANDSCAPING, GRASS AND CONCRETE BUS PAD WORK			
		NORTHBOUND	SOUTHBOUND	EASTBOUND	WESTBOUND
2 ND STREET					
Market St to	8:45 - 6PM (S/S)	10/12	10/12		
Townsend St (B/C)	8:45 - 6PM (S/S)	10/12	10/12		
	Concrete Curing	10/12	10/12		
	to Other Trades	Full Roadway	Full Roadway		
Cross Streets for 2 ND Street					
Bryant St	At All Times			Full Roadway	
Taber Alley	At All Times			Full Roadway	
Federal St	At All Times			Full Roadway	Full Roadway
South Park Ave	At All Times			Full Roadway	
De Roda St	At All Times			Full Roadway	Full Roadway
Brannan St (B/C)	At All Times			Full Roadway	Full Roadway
Townsend St (B/C)	At All Times			Full Roadway	Full Roadway



CMC
Traffic Control
Specialists

3450 3RD St Suite 305 San Francisco, CA 94124
Phone: (415) 206-1700 Fax: (415) 206-1711
Contractor License No: 792993 (Class A & C-31)

- Date: 11/09/2018 Author: PMRC Project: 1064J
Client: M2 Owner: SFPMT Location: SAN FRANCISCO
TCP: 064 CMC Job #: 1430 REV: 0
- Comments:
- 1) WORK HOURS:
 - 2) THE CONTRACTOR SHALL BE ALLOWED TO WORK AT A MAXIMUM OF 3 INTERSECTIONS AT ANY TIME.
 - 3) THE CONTRACTOR SHALL NOT PREVENT OR DELAY THE OPERATION OF MASS TRANSIT VEHICLE AT ANY TIME.
 - 4) USE A SIMILAR BUT OPPOSITE CONFIGURATION TO COMPLETE THE YELLOW CURB RAMPS SHOWN.