
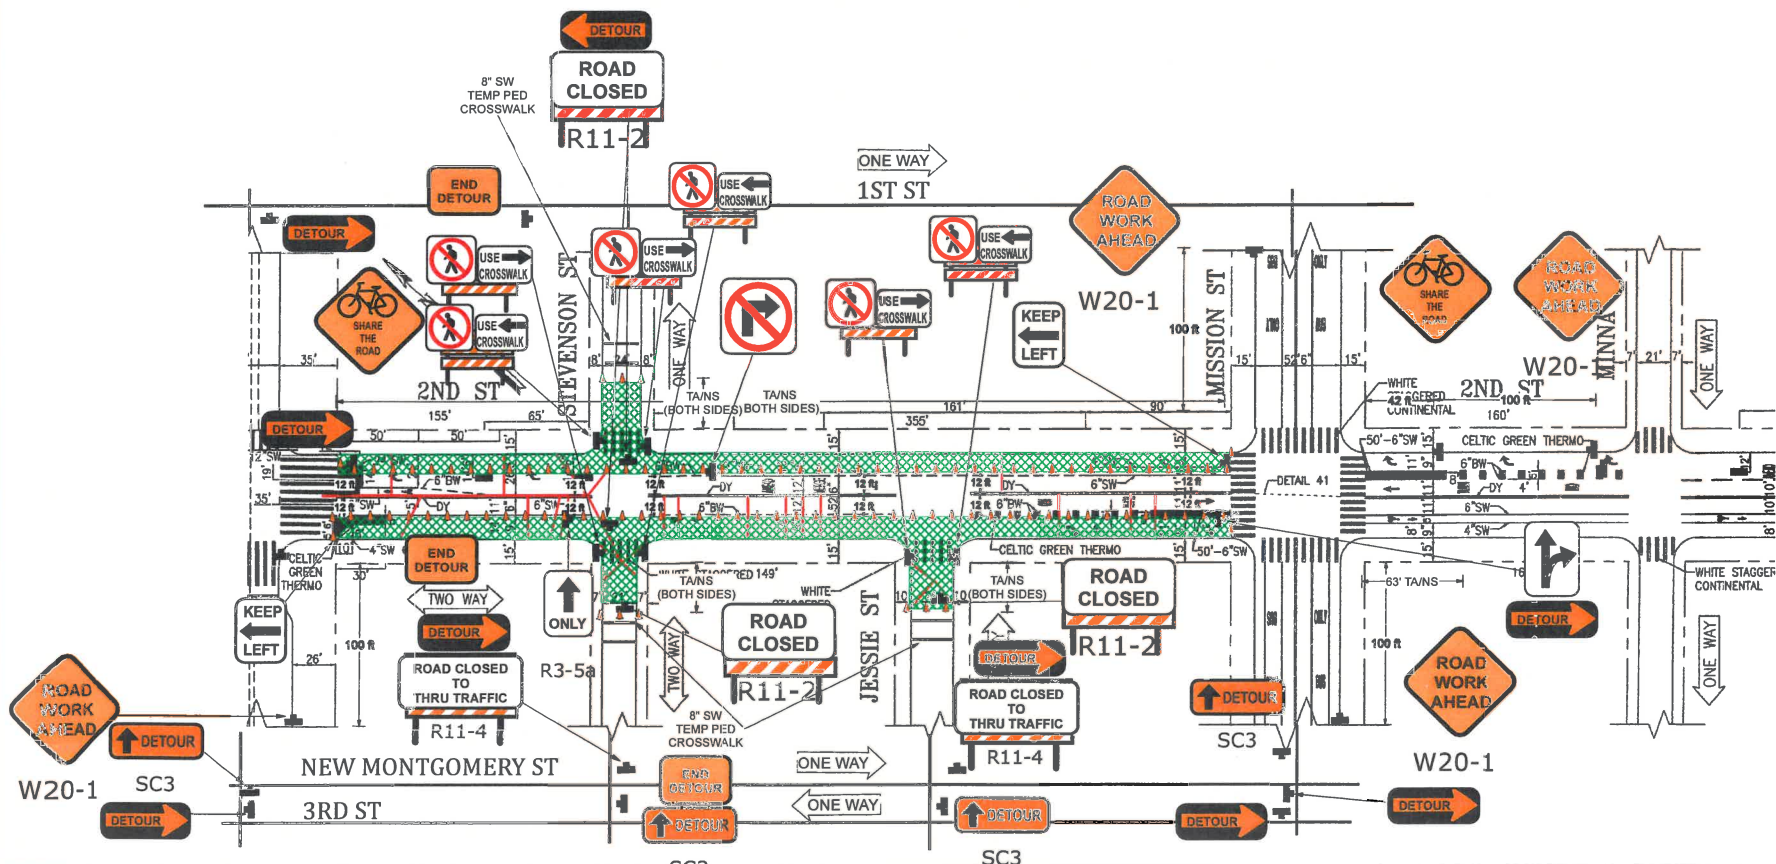


TRAFFIC CONTROL PLAN
1064J - 2ND ST IMPROVEMENTS PROJECT
WATER & SEWER WORK PLAN - 2ND ST FROM MARKET ST TO MISSION ST

STREET	TIME	NORTHBOUND	SOUTHBOUND	EASTBOUND	WESTBOUND
SEWER, SETTLEMENT PLAN, AND AWS WORK					
2 ND STREET					
Market St to King St (MC)	8AM - 5PM (M-F) 9AM - 8PM (S/S) At Other Times	1@12' 1@12'	1@12' 1@12'	-	-
Cross Streets for 2 ND Street	At All Times	-	-	Full Roadway	Full Roadway
Stevenson St	8AM - 5PM (M-F) 9AM - 8PM (S/S) At Other Times	-	-	Closed	-
Jessie St	8AM - 5PM (M-F) 9AM - 8PM (S/S) At Other Times	-	-	Closed	-
Mission St (GG, SM, TC)	At All Times	-	-	Full Roadway	Full Roadway

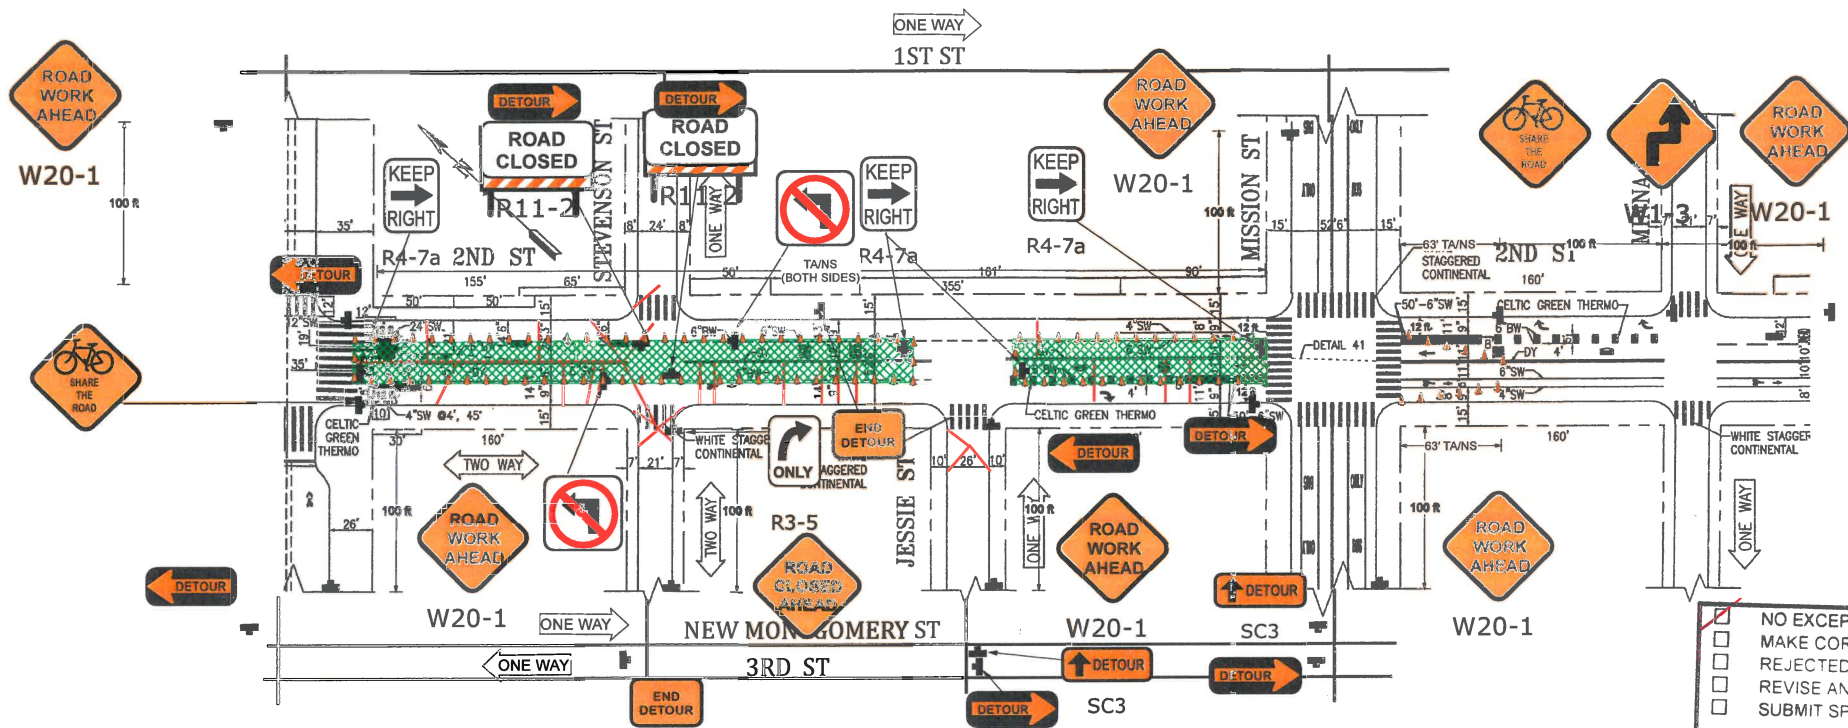

- ☒ NO EXCEPTIONS TAKEN
- ☐ MAKE CORRECTIONS NOTED
- ☐ REJECTED
- ☐ REVISE AND RESUBMIT
- ☐ SUBMIT SPECIFIED ITEM(S)

Review is only for general conformance with the design concept of the project and general compliance with the requirements of the contract documents. Any action shown is subject to the requirements of the plans and specifications. Contractor's responsibilities include but are not limited to actual dimensions which shall be confirmed and correlated at the job site; preferred fabrication processes and techniques of construction; coordination of the contractor's work with that of all other trades; and the satisfactory performance of the contractor's work.

Sustainable Streets Division
San Francisco Municipal Transportation Agency
City and County of San Francisco

By CA Date 12/7/17

- Legend
- Type III Barricade
 - 28" Traffic Cone
 - Work Area
 - Sign and Stand
 - Direction of Travel
 - Type III Barricade (Plain View)
 - ADA Pedestrian Barricades
 - NTS Not To Scale
 - TAVNS Tow-Away/No Stopping
 - Police Officer
 - Flagger
 - Type I Barricade
 - Work Truck
 - Pipe to be installed
 - Existing Utility
 - Flashing Beacon

Plan Scale
1" = 50'

CMC

Traffic Control Specialists

3450 3rd St, Suite 3G, San Francisco, CA 94124
Phone: (415) 206-1700 Fax: (415) 206-1711
Contractor License No. 792059 (Class A & C-31)

Date: 11/20/2017 Author: PM/RC Project: 1064J
Client: M2 Owner: SFPDPW Location: SAN FRANCISCO
TCP: 006 CMC Job #: 1430 REV: 1

Comments:

- 1) WORK HOURS:
- 2) SEWER RELATED WORK IS LIMITED TO ONE BLOCK AND ONE ADJACENT INTERSECTION AT ANY ONE TIME.
- 3) THE CONTRACTOR SHALL NOT PREVENT OR DELAY THE OPERATION OF MASS TRANSIT VEHICLE AT ANY TIME.