





MATCH LINE "A", STA 5+75
SEE SHEET SW-1

MATCH LINE "B", STA 11+00
SEE SHEET SW-3

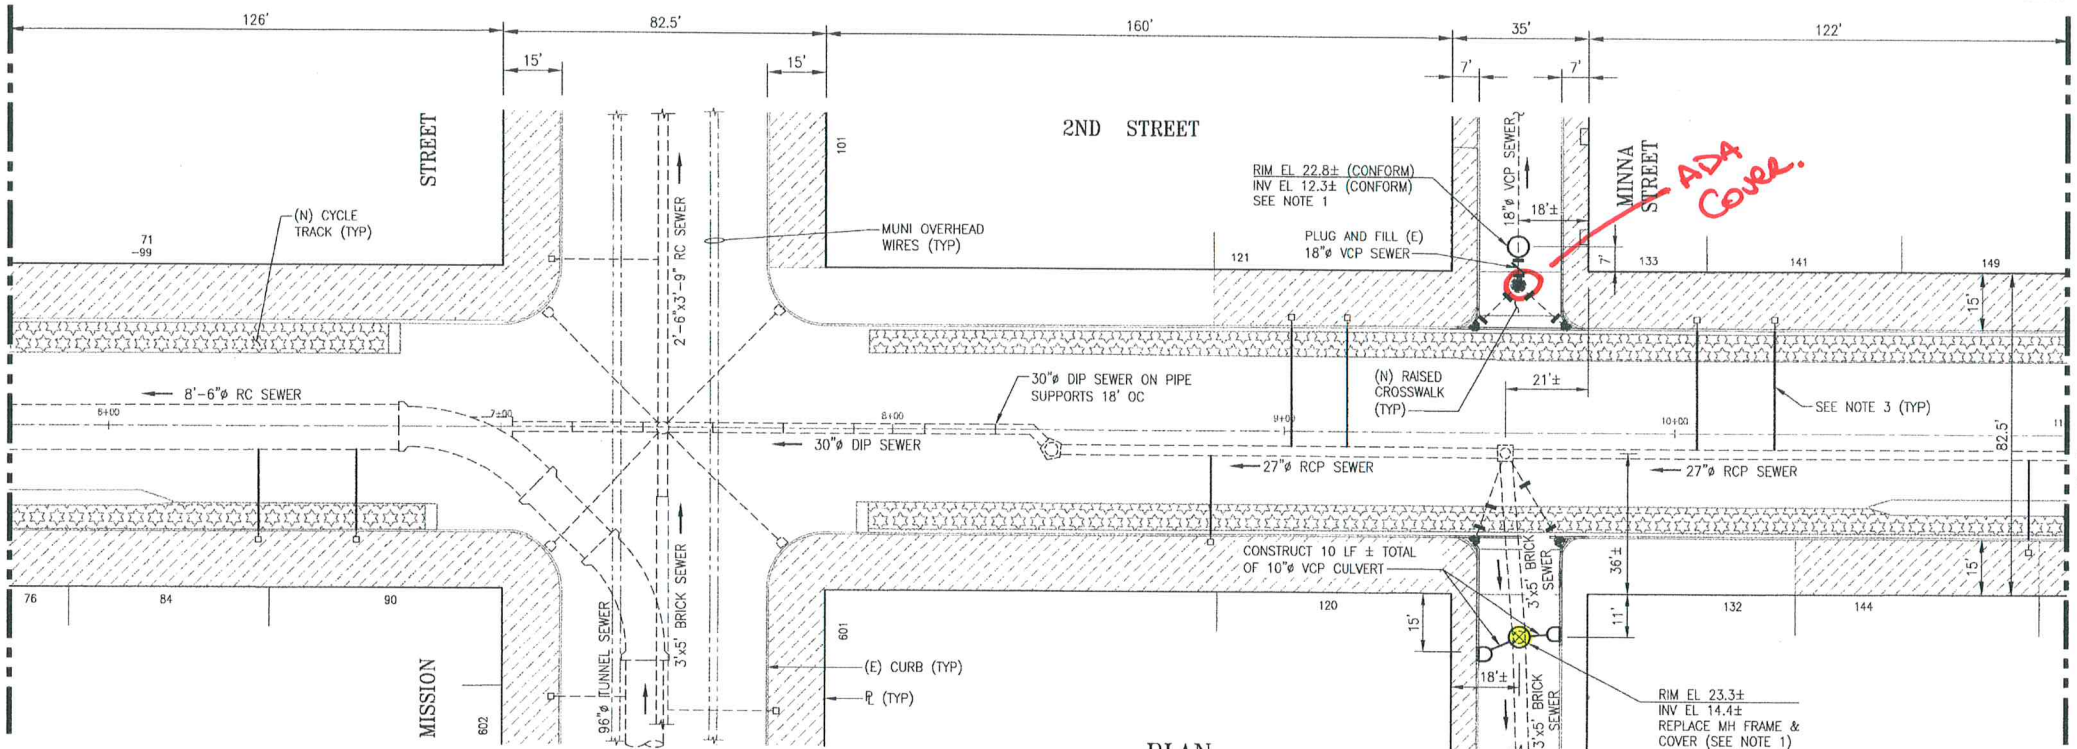


PLAN

SCALE: 1"=20'

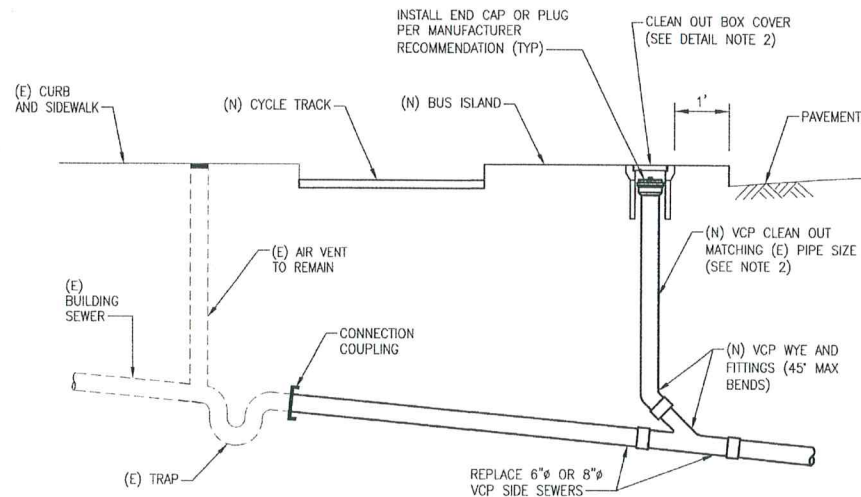

SIDE SEWER CLEAN OUT
ASSEMBLY AT (N) BUS ISLAND

SCALE: NONE

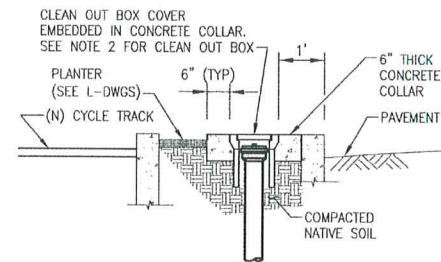

CLEAN OUT COVER AT PLANTER

DETAIL NOTES:

1. REFER TO SFPD STD PLAN 87,196 FOR ALL OTHER DETAILS.
2. CLEAN OUT BOX COVER SHALL HAVE LOCKING CAST IRON LID PER MANUFACTURER'S RECOMMENDATIONS. INSTALL ADA HEEL PROOF COVER FLUSH WITH GRADE. TEXT ON COVER SHALL BE "SEWER CO." BOX AND LID SHALL BE CHRISTY PRODUCTS OR APPROVED EQUAL.
3. AT LOCATIONS WITH PLANTING, FRESH AIR INLET SHALL HAVE 6" CONC COLLAR AND SHALL BE SET FLUSH W/ NEW CURB. CONC COLLAR SHALL BE EMBEDDED 6" INTO PLANTING MEDIA.

NOTES:

1. CONTRACTOR SHALL ADJUST MANHOLE FRAMES AND COVERS TO PROPOSED GRADES. REFER TO R-DWGS FOR PROPOSED ELEVATIONS.
2. SEE R-DWGS FOR PROPOSED ROADWAY IMPROVEMENTS INCLUDING, BUT NOT LIMITED TO, RAISED CROSSWALKS, BUS ISLANDS, AND VARIOUS BUFFER ZONES.
3. CONTRACTOR TO IDENTIFY ALL ACTIVE SIDE SEWERS WITHIN RAISED CYCLE TRACK LIMITS AND REPLACE ALL OF THEM FROM THE CURB TO THE MAIN SEWER. INVESTIGATION OF SIDE SEWERS SHALL BE COMPLETED PER CONTRACT SPECIFICATIONS PRIOR TO REPLACEMENT WORK.
4. CONTRACTOR SHALL NOTIFY CITY REPRESENTATIVE IF EXISTING SIDE SEWER CONNECTIONS ARE DEFECTIVE. IF DETERMINED BY CITY REPRESENTATIVE THAT THE CONNECTION REQUIRES REPLACEMENT, SIDE SEWER CONNECTION TO RC SEWERS/RCP/BRICK SHALL BE CONSTRUCTED PER DETAILS ON SW-4. SIDE SEWER CONNECTIONS TO VCP SHALL BE PER CONTRACT SPECIFICATIONS. CITY REPRESENTATIVE MAY ALSO REQUIRE CONTRACTOR TO LINE (E) SIDE SEWERS WITH CIPL.

ELEVATION
DATUM
SFVD13


NO.	DATE	DESCRIPTION	BY	APP.
0	10/16	ISSUED FOR BIDS	AS	LW
TABLE OF REVISIONS				

REFERENCE INFORMATION
& FILE NO. OF SURVEYS
50,158
55,281.7
55,279



DESIGN &
ENGINEERING
CITY & COUNTY OF SAN FRANCISCO
SAN FRANCISCO PUBLIC WORKS
30 VANNESS AVENUE, 5TH FLOOR
SAN FRANCISCO, CA 94102 - 6028

Section Mgr. <i>Lesley Wong</i>	LESLEY WONG	Date: 11/9/16
Deputy Division Mgr. <i>IQBAL DHAPA</i>	IQBAL DHAPA	11/14/16
Division Mgr. <i>PATRICK RIVERA</i>	PATRICK RIVERA	11/15/16
DESIGNED: J.K./A.S.	DATE: 11/2016	
DRAWN: A.KIRSCH	DATE: 11/2016	
CHECKED: G.FONG	DATE: 11/2016	

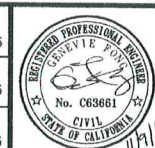

SCALE:
AS NOTED
SHEET OF SHEETS

2ND STREET STREETSCAPE
IMPROVEMENTS PROJECT

2ND STREET SEWER REPLACEMENT
STATION 5+75 TO 11+00
PLAN AND DETAIL

CONTRACT NO.
1064J(R)
DRAWING NO.
SW-2
FILE NO.
106,244
REV. NO.
0