



?
TRAFFIC CONTROL PLAN
1064J - 2ND ST IMPROVEMENTS PROJECT
CURB RAMP WORK PLAN - 2ND ST FROM MARKET ST TO MISSION ST

WORK HOUR

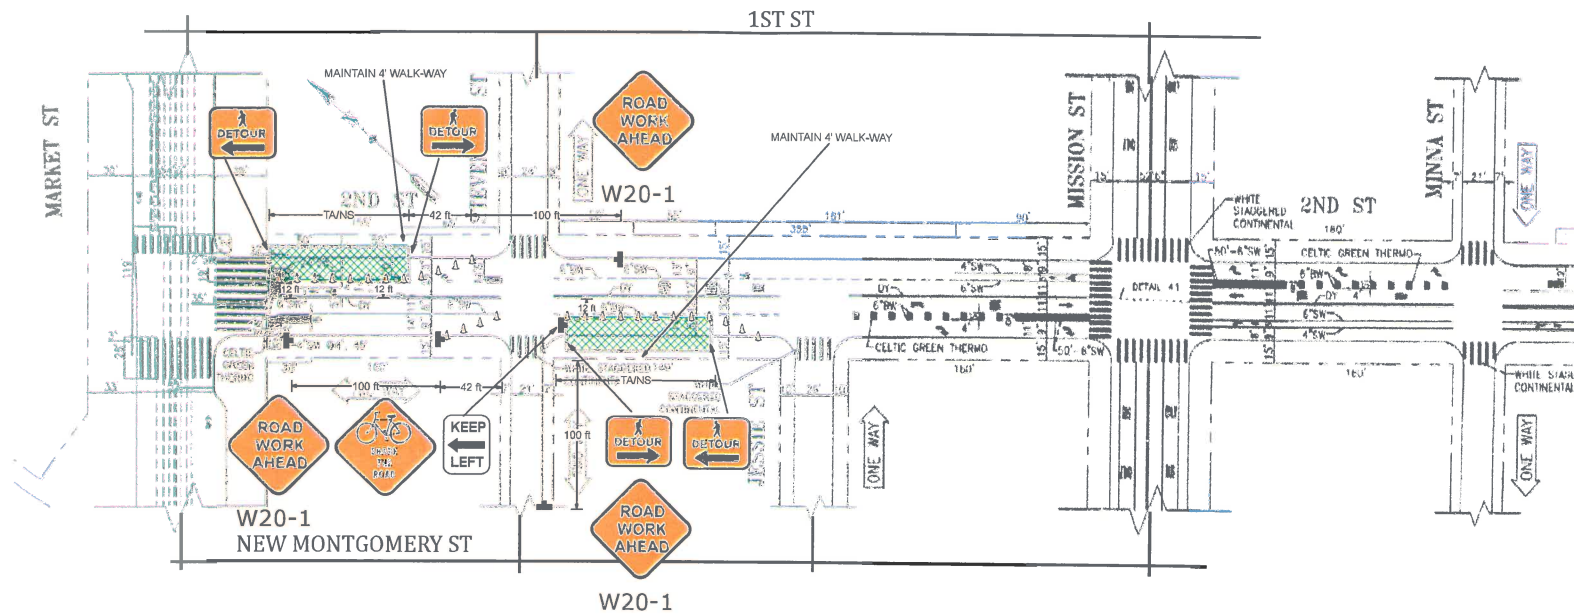

NON-WORK HOUR

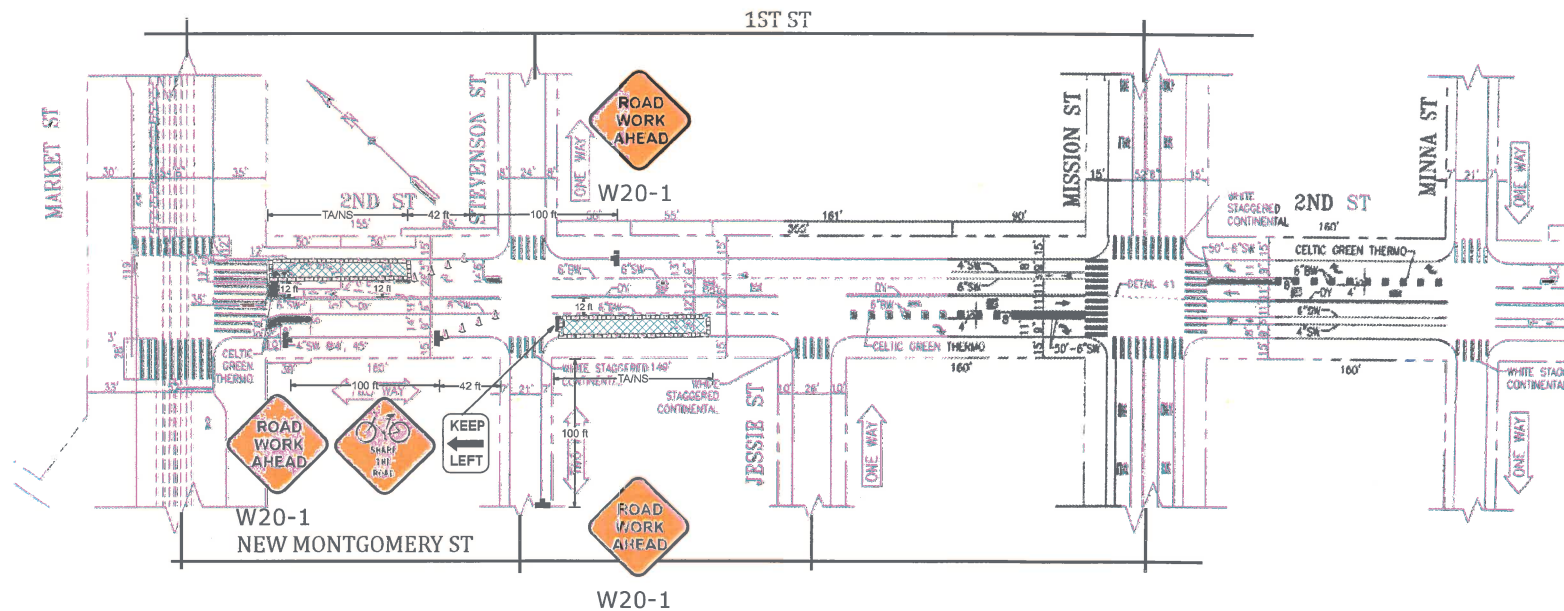

- ☐ NO EXCEPTIONS TAKEN
- ☒ MAKE CORRECTIONS NOTED
- ☐ REJECTED
- ☐ REVISE AND RESUBMIT
- ☐ SUBMIT SPECIFIED ITEM(S)

Review is only for general conformance with the design concept of the project and general compliance with the requirements of the contract documents. Any action shown is subject to the requirements of the plans and specifications. Contractor's responsibilities include, but are not limited to, actual dimensions which shall be confirmed and correlated at the job site, preferred fabrication processes and techniques of construction, coordination of the contractor's work with that of all other trades, and the satisfactory performance of the contractor's work.

Sustainable Streets Division
 San Francisco Municipal Transportation Agency
 City and County of San Francisco

By **CA** Date **10/30/17**

- Legend**
- Type II Barricade
 - 26" Traffic Cone
 - Work Area
 - Sign and Stand
 - Direction of Travel
 - Type III Barricade (Plain View)
 - ADA Pedestrian Barricades
 - NTS Not To Scale
 - TANS Tow-Away/No Stopping
 - Police Officer
 - Flagger
 - Type I Barricade
 - Work Truck
 - Pipe to be installed
 - Existing Utility
 - Flashing Beacon



Plan Scale
 1" = 50'

CMC

Traffic Control Specialists

3450 3rd St Suite 303, San Francisco, CA 94124
 Phone: (415) 206-1700 Fax: (415) 206-1711
 Contractor License No. 792069 (Class A & C-31)

Date: 10/02/2017 Author: PM/RC Project: 1064J
 Client: M2 Owner: SFPD Location: SAN FRANCISCO
 TCP: 010 CMC Job #: 1430 REV: 1

Comments:

- 1) WORK HOURS:
- 2) THE CONTRACTOR SHALL BE ALLOWED TO WORK AT A MAXIMUM OF 3 INTERSECTIONS AT ANY TIME.
- 3) THE CONTRACTOR SHALL NOT PREVENT OR DELAY THE OPERATION OF MASS TRANSIT VEHICLE AT ANY TIME.
- 4) USE A SIMILAR BUT OPPOSITE CONFIGURATION TO COMPLETE THE YELLOW CURB RAMPS SHOWN.