


PLAN
SCALE: 1"=20'

NOTES:

1. CONTRACTOR SHALL ADJUST MANHOLE FRAMES AND COVERS TO PROPOSED GRADES. REFER TO R-DWGS FOR PROPOSED ELEVATIONS.
2. SEE R-DWGS FOR PROPOSED ROADWAY IMPROVEMENTS INCLUDING, BUT NOT LIMITED TO, RAISED CROSSWALKS, BUS ISLANDS, AND VARIOUS BUFFER ZONES.
3. CONTRACTOR TO IDENTIFY ALL ACTIVE SIDE SEWERS WITHIN RAISED CYCLE TRACK LIMITS AND REPLACE ALL OF THEM FROM THE CURB TO THE RELOCATED FRESH AIR INLET. INVESTIGATION OF SIDE SEWERS SHALL BE COMPLETED PER CONTRACT SPECIFICATIONS PRIOR TO REPLACEMENT WORK.
5. CONTRACTOR SHALL NOTIFY CITY REPRESENTATIVE IF EXISTING SIDE SEWER CONNECTIONS ARE DEFECTIVE. IF DETERMINED BY CITY REPRESENTATIVE THAT THE CONNECTION REQUIRES REPLACEMENT, SIDE SEWER CONNECTION TO RC SEWERS/RCP/BRICK SHALL BE CONSTRUCTED PER DETAILS ON SW-4. SIDE SEWER CONNECTIONS TO VCP SHALL BE PER CONTRACT SPECIFICATIONS. CITY REPRESENTATIVE MAY ALSO REQUIRE CONTRACTOR TO LINE (E) SIDE SEWERS WITH CIPL.

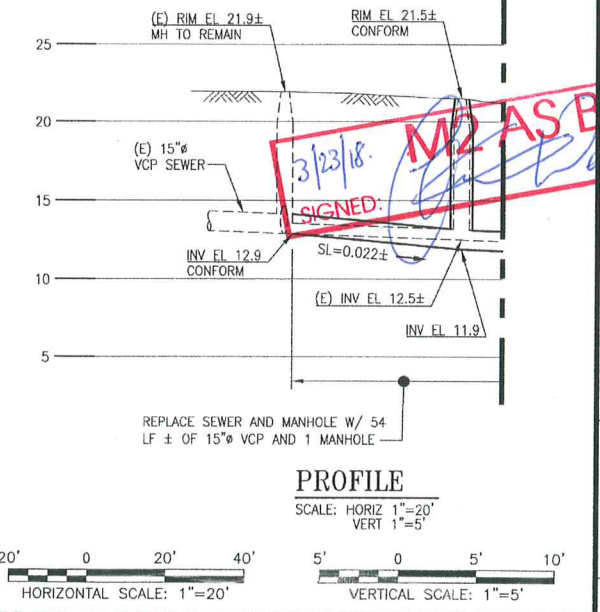

PROFILE
SCALE: HORIZ 1"=20'
VERT 1"=5'

Sw-6=2
Sw-27=16LF
Sw-30=1
Sw-32
4x4x7=4cy
x2
8cy

MODIFIED CALTRANS TYPE G3 CATCH BASIN

SCALE: NONE

ELEVATION DATUM SFVD13	SEWER SIZED BY B.A. [Signature]
	APPROVED BY B.S. [Signature]

NO.	DATE	DESCRIPTION	BY	APP.
0	10/16	ISSUED FOR BIDS	AS	LW
TABLE OF REVISIONS				

REFERENCE INFORMATION & FILE NO. OF SURVEYS
90.833
41.274
A-320



DESIGN & ENGINEERING
CITY & COUNTY OF SAN FRANCISCO
SAN FRANCISCO PUBLIC WORKS
30 VAN NESS AVENUE, 5TH FLOOR
SAN FRANCISCO, CA 94102 - 0028

Section Mgr. [Signature]	LESLEY WONG	Date: 11/9/16
Deputy Division Mgr. [Signature]	IOBAL DHAPA	11/14/16
Division Mgr. [Signature]	PATRICK RIVERA	11/15/16

DESIGNED: DATE: J.K./A.S. 11/2016
DRAWN: DATE: A.KIRSCH 11/2016
CHECKED: DATE: G.FONG 11/2016



SCALE: AS NOTED
SHEET OF SHEETS

2ND STREET STREETSCAPE IMPROVEMENTS PROJECT
2ND STREET SEWER REPLACEMENT STATION 42+00 TO 46+00 PLAN AND PROFILE

CONTRACT NO. 1064J(R)
DRAWING NO. SW-9
FILE NO. 106.251
REV. NO. 0