


M2 PP #15  
AS-BUILT.

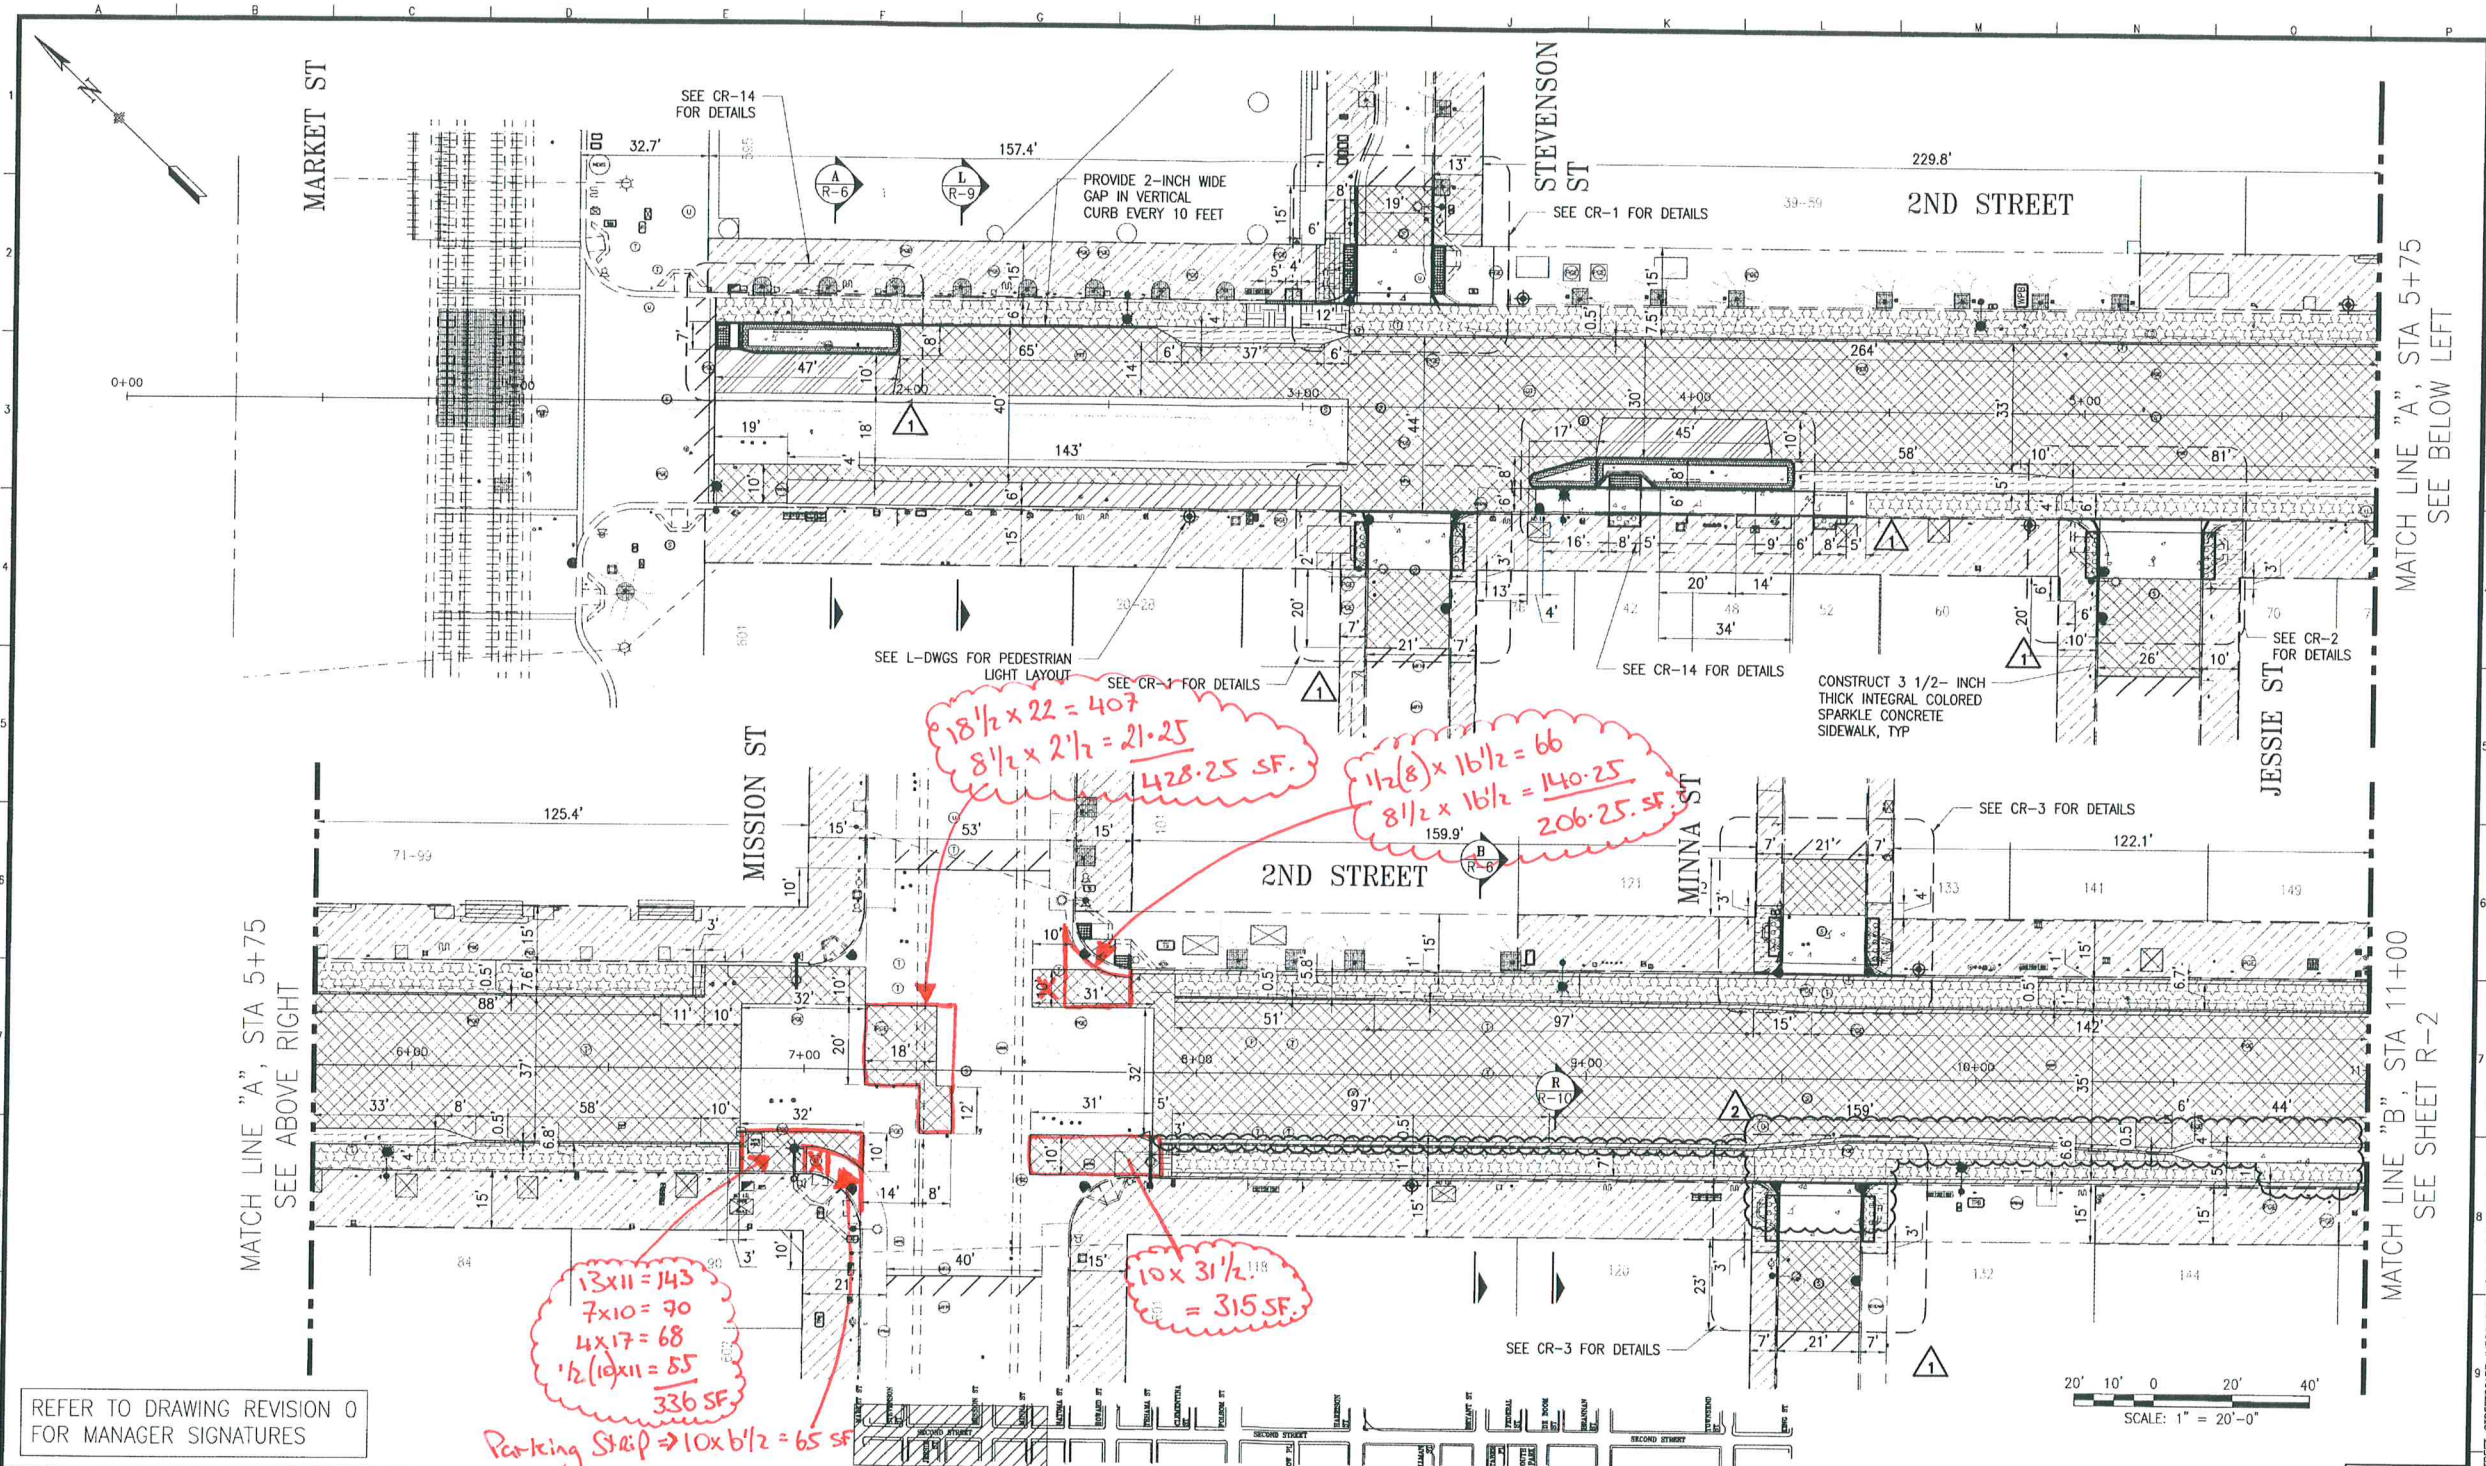


MATCH LINE "A", STA 5+75  
SEE BELOW LEFT

MATCH LINE "B", STA 11+00  
SEE SHEET R-2

REFER TO DRAWING REVISION 0  
FOR MANAGER SIGNATURES

TABLE OF REVISIONS				
NO.	DATE	DESCRIPTION	BY	APP.
2	09/18	REVISE CYCLETRACK WIDTH; ADD CUTTER	KC	DMC
1	05/18	REVISE BUS PAD LAYOUT, GRADES, AND DRAINAGE	KC	DMC

REFERENCE INFORMATION & FILE NO. OF SURVEYS	

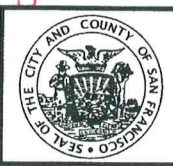

BUREAU OF DESIGN & ENGINEERING  
PUBLIC WORKS  
CITY & COUNTY OF SAN FRANCISCO  
30 VAN NESS AVENUE, 5TH FLOOR  
SAN FRANCISCO, CA 94102 - 6028

Acting Section Mgr: ERIC KJELSBERG  
Deputy Division Mgr: FERNANDO CISNEROS  
Division Mgr: PATRICK RIVERA

DESIGNED: DATE: K.CHANG 09/18  
DRAWN: DATE: K.CHANG 09/18  
CHECKED: DATE: D.CALLEROS 09/18



SCALE: 1" = 20'  
SHEET OF SHEETS

SECOND STREET IMPROVEMENT PROJECT  
PAVEMENT PLAN  
2ND STREET  
STATION 0+00 TO 11+00

EHY JO NO. 2835J  
CONTRACT NO. 1064J (R)  
DRAWING NO. R-1  
FILE NO. 106,159  
REV. NO. 2

Drawing Path: V:\1064J\_SECOND\_STREET\_STREETSCAPE\_IMPROVEMENTS\2.Design\Working\Drawings\ESH\CURRENT\01.Dwg  
Plot Time: Thu, 06 Sep 2018 - 3:52pm  
Measurement Units are English  
Model Units: Feet  
Xrefs: V:\1064J\_SECOND\_STREET\_STREETSCAPE\_IMPROVEMENTS\Official\Project\_TBA\DEL\_TBO.ESB-rebid.dwg  
V:\1064J\_SECOND\_STREET\_STREETSCAPE\_IMPROVEMENTS\2.Design\Working\Drawings\ESH\CURRENT\rebid-2017-03-24\1064J - 2ND S  
V:\1980L\_2ND\_STREET\_SEWER\_REPLACEMENT\2.Design\Working\Drawings\ESH\Current\1980L\_U1-U10.dwg  
V:\1064J\_SECOND\_STREET\_STREETSCAPE\_IMPROVEMENTS\2.Design\Working\Drawings\ESH\Current\1980L\_U1-U10.dwg

R-6 = 970.5 SF  
R-9 = 65 SF.