


TRAFFIC CONTROL PLAN  
1064J - 2ND ST IMPROVEMENTS PROJECT  
BASE REPAIR WORK PLAN - 2ND ST FROM MISSION ST TO HOWARD ST

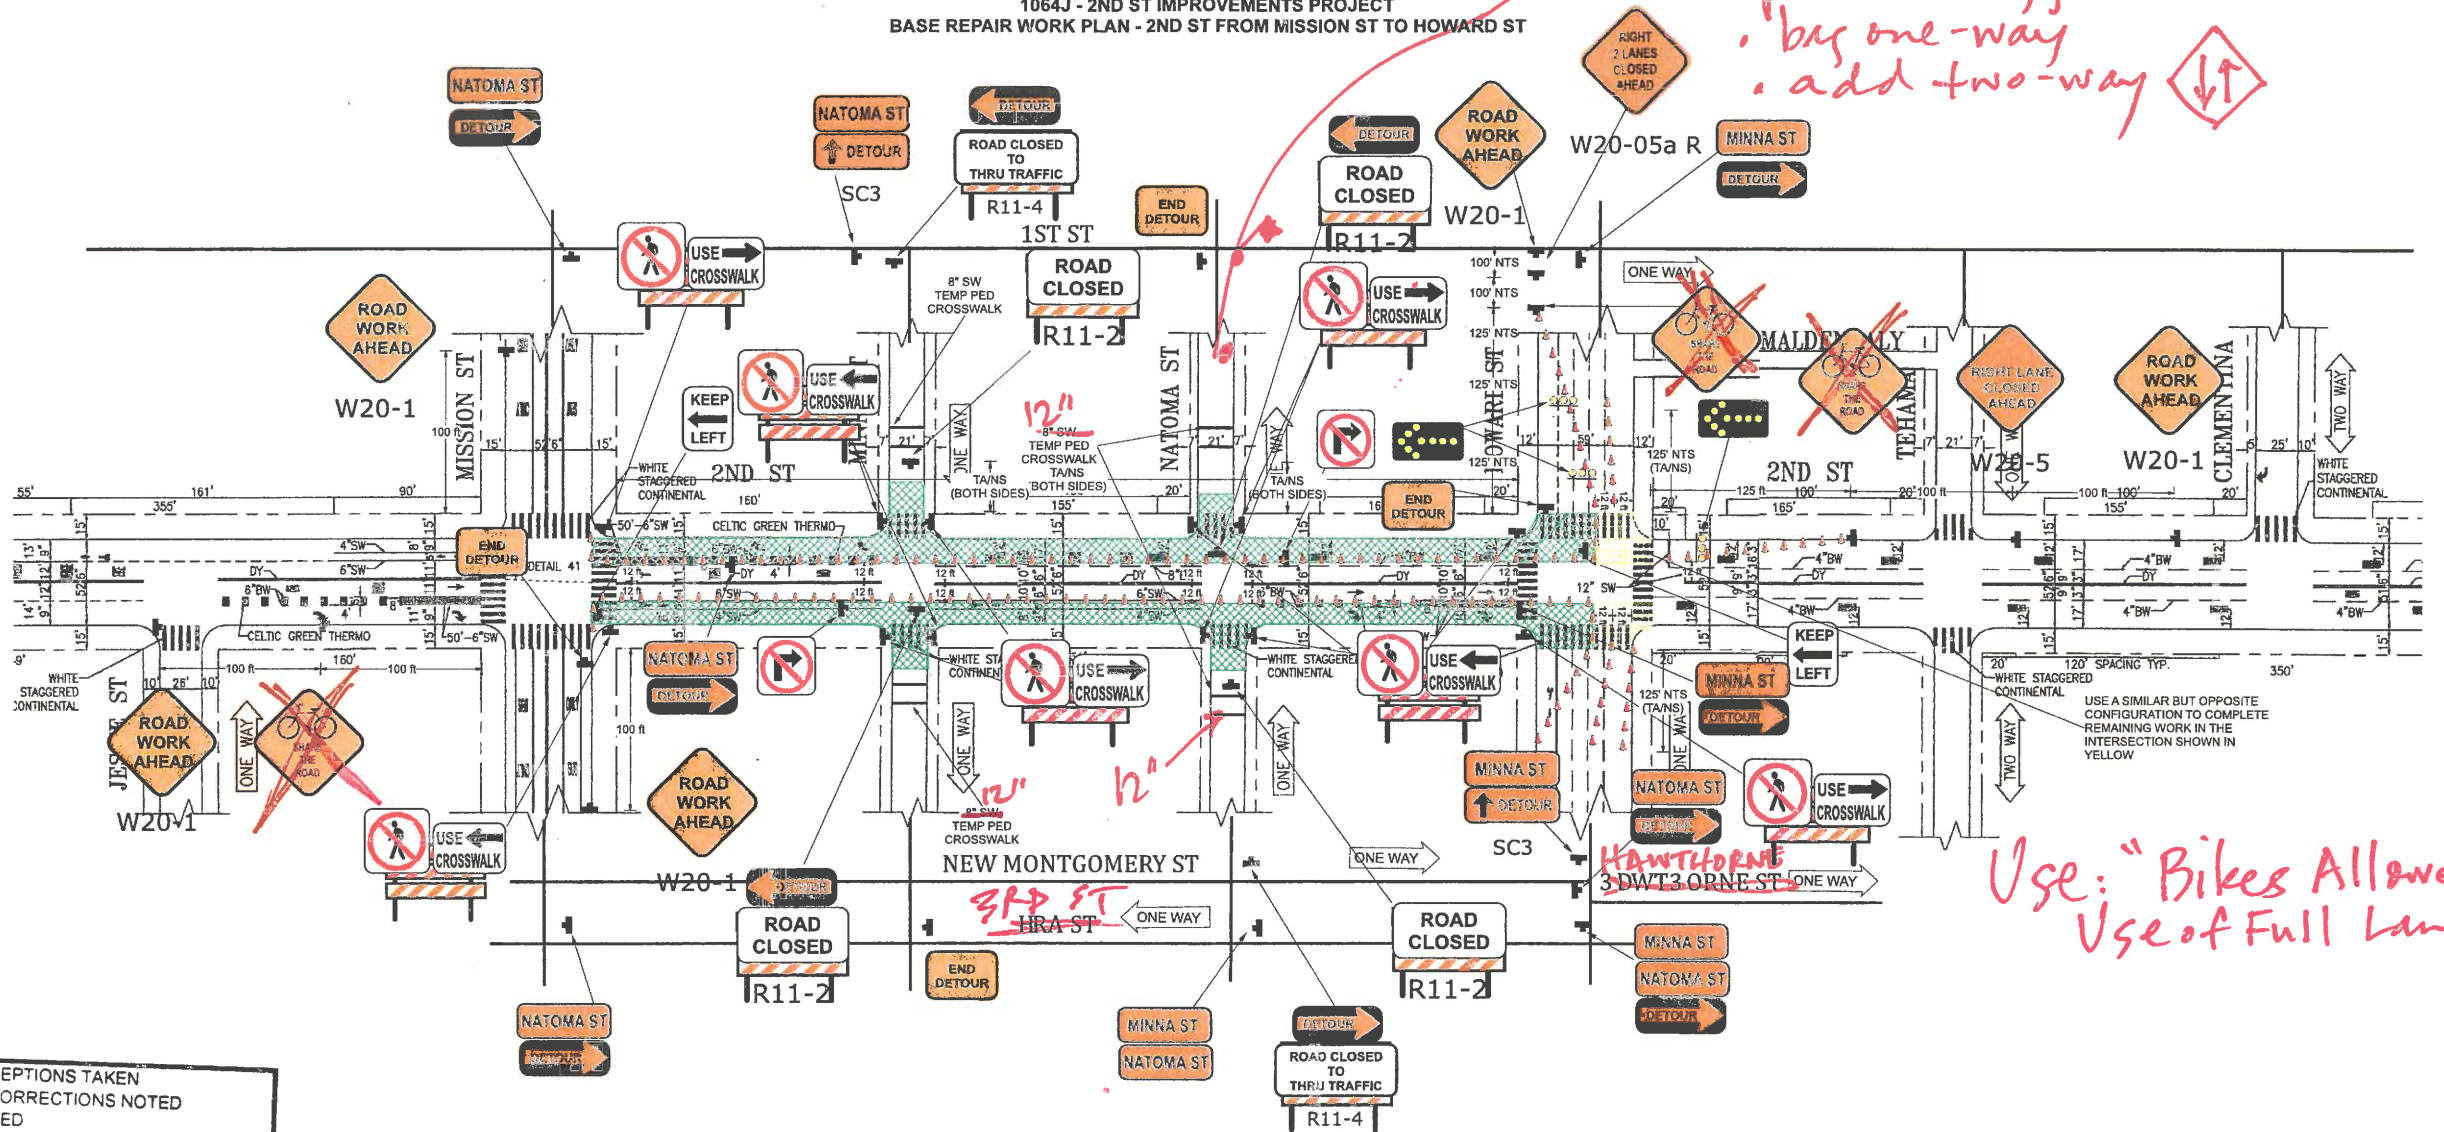

- ☐ NO EXCEPTIONS TAKEN
- ☒ MAKE CORRECTIONS NOTED
- ☐ REJECTED
- ☐ REVISE AND RESUBMIT
- ☐ SUBMIT SPECIFIED ITEM(S)

Review is only for general conformance with the design concept of the project and general compliance with the requirements of the contract documents. Any action shown is subject to the requirements of the plans and specifications. Contractor's responsibilities include, but are not limited to actual dimensions which shall be confirmed and correlated at the job site; preferred fabrication processes and techniques of construction; coordination of the contractor's work with that of all other trades; and the satisfactory performance of the contractor's work.

Sustainable Streets Division  
San Francisco Municipal Transportation Agency  
City and County of San Francisco

By DS Date 7/26/18



**Legend**

- Type III Barricade
- 28" Traffic Cone
- Work Area
- Sign and Stand
- Direction of Travel
- Type III Barricade (Plain View)
- ADA Pedestrian Barricades
- NTS Not To Scale
- T/ANS Tow-Away/No Stopping
- Police Officer
- Flagger
- Type I Barricade
- Work Truck
- Pipe to be installed
- Existing Utility
- Flashing Beacon

STREET	TIME	NORTHBOUND	SOUTHBOUND	EASTBOUND	WESTBOUND
<b>CONCRETE SUB-BASE REPAIR, GRINDING, AND PAVING WORK</b>					
2 <sup>nd</sup> STREET					
Market St to King St (MC)	8AM - 5PM (M-F) 9AM - 6PM (S/S) At Other Times	1@12 1@12 Full Roadway	1@12 1@12 Full Roadway	-	-
Cross Streets for 2 <sup>nd</sup> Street					
Mission St (GG, SM, TC)	8AM - 3PM (M-F) 9AM - 6PM (S/S) At Other Times	-	-	1@12 1@12 Full Roadway	1@12 1@12 Full Roadway
Minna St	8AM - 5PM (M-F) 9AM - 6PM (S/S) At Other Times	-	-	-	Closed@ Closed@ Full Roadway
Natoma St	8AM - 5PM (M-F) 9AM - 6PM (S/S) At Other Times	-	-	Closed@ Closed@ Full Roadway	-
Howard St (GG)	10AM - 4PM (M-F) 7AM - 4PM (S/S) At Other Times	-	-	-	2@12 2@12 Full Roadway

**CMC**  
**Traffic Control**  
**Specialists**

3450 3<sup>rd</sup> St, Suite 3G, San Francisco, CA 94124  
Phone: (415) 206-1700 Fax: (415) 206-1711

Contractor License No. 792059 (Class A & C-31)

Plan Scale  
1" = 50'

Date: 05/17/2018 Author: PM/RC Project: 1064J  
Client: M2 Owner: SFPDW Location: SAN FRANCISCO  
TCP: 040 CMC Job #: 1430 REV: 0

- Comments:**
- 1) WORK HOURS:
  - 2) BASE REPAIR WORK WILL BE ALLOWED UP TO 2 CONSECUTIVE BLOCKS AND 2 CONSECUTIVE INTERSECTIONS.
  - 3) THE CONTRACTOR SHALL NOT PREVENT OR DELAY THE OPERATION OF MASS TRANSIT VEHICLE AT ANY TIME.