



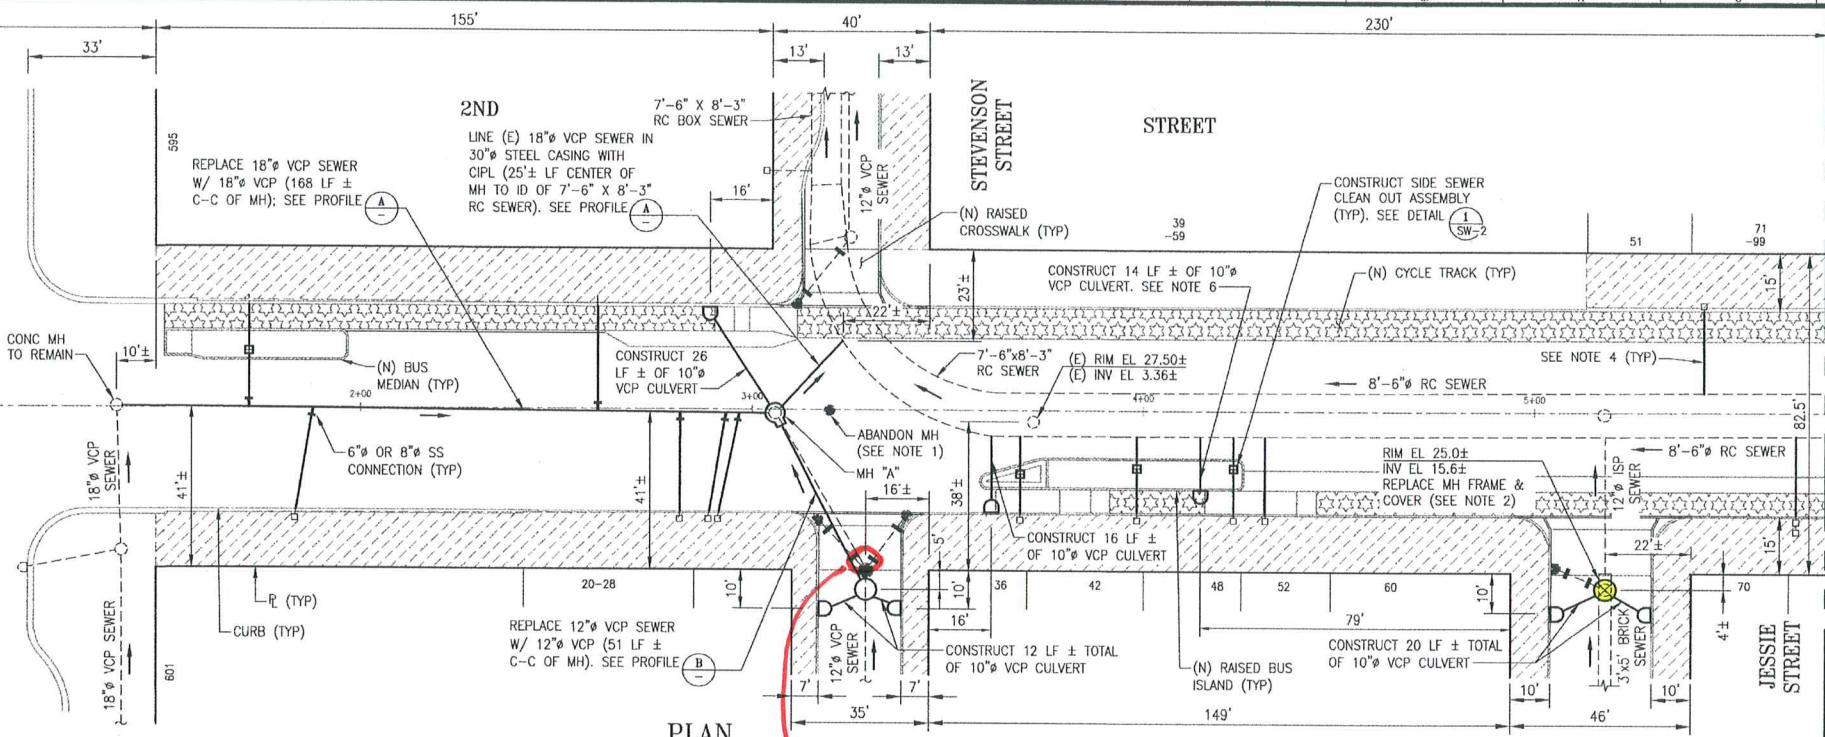

MARKET STREET

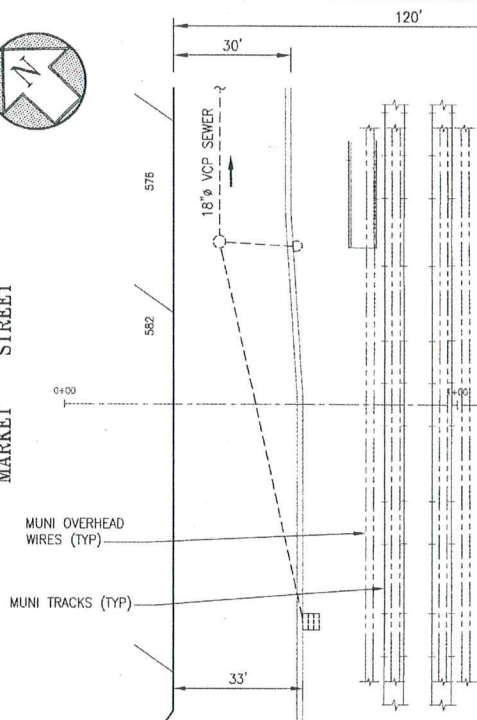


MATCH LINE "A", STA 5+75
SEE SHEET SW-2

NOTES:

- CONTRACTOR TO ABANDON INACTIVE MH PER DPW STANDARD SPECIFICATIONS.
- CONTRACTOR SHALL ADJUST MANHOLE FRAMES AND COVERS TO PROPOSED GRADES. REFER TO R-DWGS FOR PROPOSED ELEVATIONS.
- SEE R-DWGS FOR PROPOSED ROADWAY IMPROVEMENTS INCLUDING, BUT NOT LIMITED TO, RAISED CROSSWALKS, BUS ISLANDS, AND VARIOUS BUFFER ZONES.
- CONTRACTOR TO IDENTIFY ALL ACTIVE SIDE SEWERS WITHIN RAISED CYCLE TRACK LIMITS AND REPLACE ALL OF THEM FROM THE CURB TO THE MAIN SEWER. INVESTIGATION OF SIDE SEWERS SHALL BE COMPLETED PER CONTRACT SPECIFICATIONS PRIOR TO REPLACEMENT WORK.
- CONTRACTOR SHALL NOTIFY CITY REPRESENTATIVE IF EXISTING SIDE SEWER CONNECTIONS ARE DEFECTIVE. IF DETERMINED BY CITY REPRESENTATIVE THAT THE CONNECTION REQUIRES REPLACEMENT, SIDE SEWER CONNECTION TO RC SEWERS/RCP/BRICK SHALL BE CONSTRUCTED PER DETAILS ON SW-4. SIDE SEWER CONNECTIONS TO VCP SHALL BE PER CONTRACT SPECIFICATIONS. CITY REPRESENTATIVE MAY ALSO REQUIRE CONTRACTOR TO LINE (E) SIDE SEWERS WITH CIPL.
- CONTRACTOR SHALL LAYOUT CB AND NEW AWSS LINE PRIOR TO CONSTRUCTION TO CONFIRM CLEARANCE BETWEEN CB AND AWSS LINE. IF LESS THAN 2'-FT CLEARANCE, ADJUST OR DELETE CB PER CITY REPRESENTATIVE'S DIRECTION.

MARKET STREET

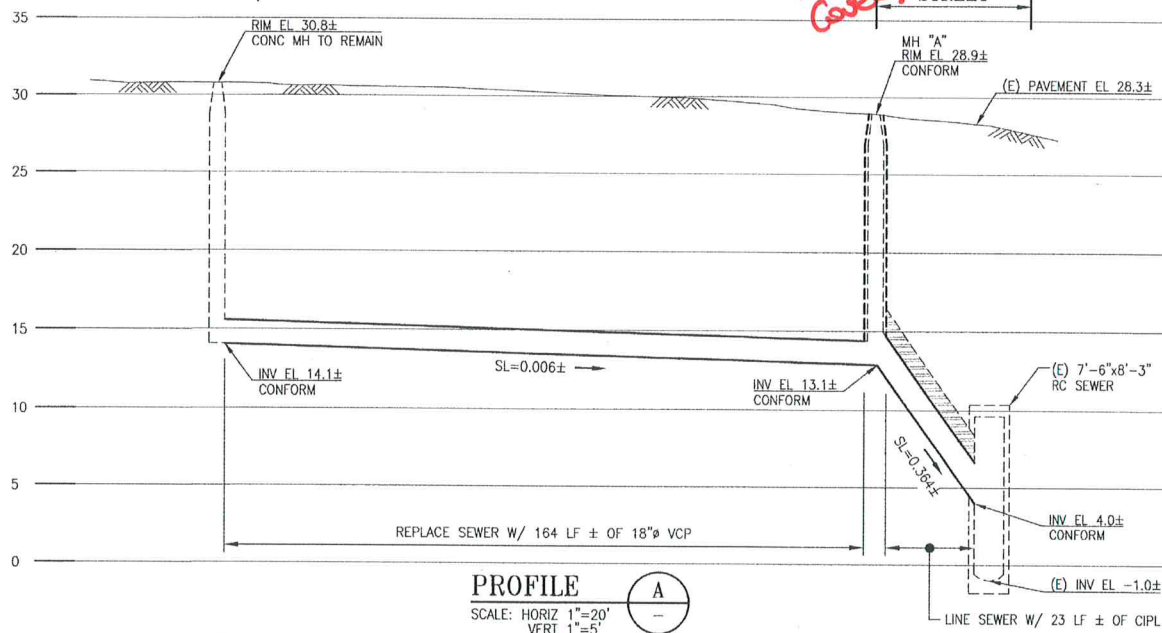


PROFILE

SCALE: HORIZ 1"=20'
VERT 1"=5'

STEVENSON STREET

ADA
Cover

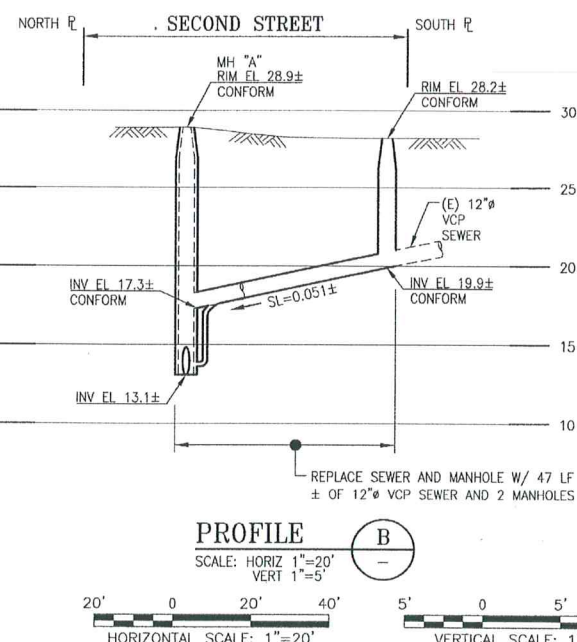

PROFILE

SCALE: HORIZ 1"=20'
VERT 1"=5'

ELEVATION DATUM SFVD13	SEWER SIZED BY B.A. BA
	APPROVED BY B.S. BS


REFERENCE INFORMATION
& FILE NO. OF SURVEYS
50,158
55,281.7
55,279



DESIGN & ENGINEERING
CITY & COUNTY OF SAN FRANCISCO
SAN FRANCISCO PUBLIC WORKS
30 VAN NESS AVENUE, 6TH FLOOR
SAN FRANCISCO, CA 94102 - 6028

Section Mgr. LESLEY WONG	Date: 11/9/16
Deputy Division Mgr. IOBAL DHAPA	Date: 11/14/16
Division Mgr. PATRICK RIVERA	Date: 11/15/16

DESIGNED: J.K./A.S.	DATE: 11/2016
DRAWN: A.KIRSCHE	DATE: 11/2016
CHECKED: G.FONG	DATE: 11/2016

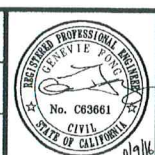

SCALE: AS NOTED
SHEET OF SHEETS

2ND STREET STREETSCAPE IMPROVEMENTS PROJECT	CONTRACT NO. 1064J(R)
2ND STREET SEWER REPLACEMENT STATION 0+00 TO 5+75 PLAN AND PROFILES	DRAWING NO. SW-1
	FILE NO. 106,243
	REV. NO. 0