



COVER/PLATE "A": PLAN VIEW

NOT TO SCALE

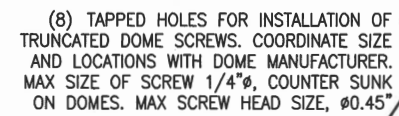


COVER/ PLATE "B": PLAN VIEW

NOT TO ~~SCALE~~

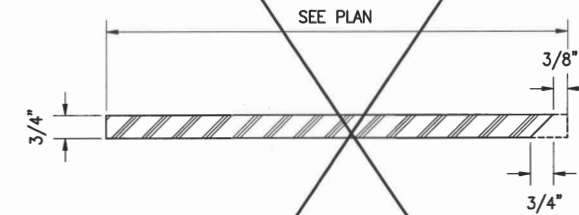

SECTION AT PICK HOLE

~~NOT TO SCALE~~

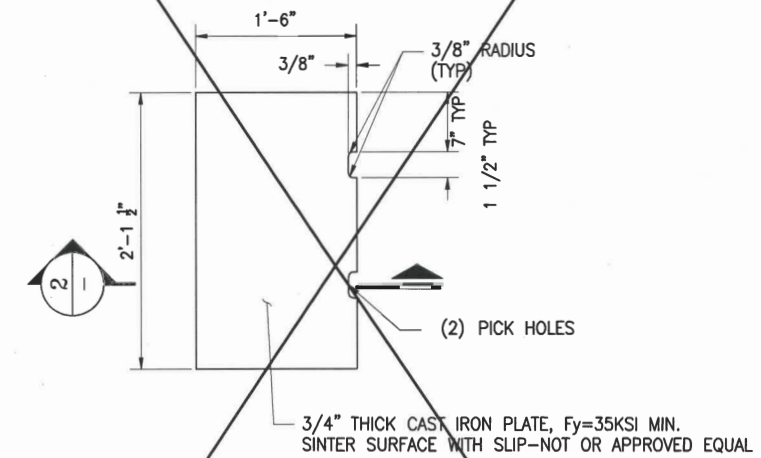


COVER PLATE "C": PLAN VIEW

NOT TO SCALE

REFER TO DRAWING REVISION 0
FOR MANAGER SIGNATURES

1	12/18	REMOVE FROM CONTRACT	KC	DMC
NO.	DATE	DESCRIPTION	BY	APP.
TABLE OF REVISIONS				
THIS DRAWING WAS LAST MODIFIED: 12/10/18 17:40, BY: kchong				

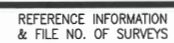

**BUREAU OF DESIGN &
ENGINEERING**
PUBLIC WORKS
CITY & COUNTY OF SAN FRANCISCO

30 VAN NESS AVENUE, 5TH FLOOR
SAN FRANCISCO, CA 94102 - 6028

Acting Section Mgr. ERIC KJELSGERD

Deputy Division Mgr. FERNANDO CISNEROS

Division Mgr. PATRICK RIVERA

DESIGNED: K.CHANG	DATE: 12/18
DRAWN: K.CHANG	DATE: 12/18
CHECKED: J. NG	DATE: 12/18



SCALE:
N.T.S.
SHEET OF SHEETS

SECOND STREET IMPROVEMENT PROJECT

NATOMA STREET
COVER PLATE DETAILS

EHY JO NO. 2835J

CONTRACT NO.	1064J (R)
DRAWING NO.	R-12C
FILE NO.	106,335.3
REV. NO.	1