



MATCH LINE "D", STA 22+00  
SEE SHEET SW-4


MATCH LINE "E", STA 27+50  
SEE SHEET SW-6

10" DIP.  
42 LF

DOW  
PLACE

29 LF  
8" VCP.

PLAN  
SCALE: 1"=20'

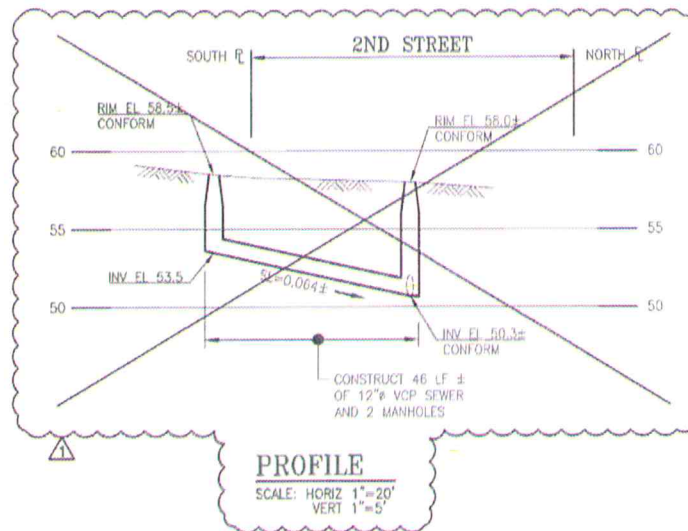

PROFILE  
SCALE: HORIZ 1"=20'  
VERT 1"=5'

#### NOTES:

1. CONTRACTOR SHALL ADJUST MANHOLE FRAMES AND COVERS TO PROPOSED GRADES. REFER TO R-DWGS FOR PROPOSED ELEVATIONS.
2. SEE R-DWGS FOR PROPOSED ROADWAY IMPROVEMENTS INCLUDING, BUT NOT LIMITED TO, RAISED CROSSWALKS, BUS ISLANDS, AND VARIOUS BUFFER ZONES.
3. CONTRACTOR TO IDENTIFY ALL ACTIVE SIDE SEWERS WITHIN RAISED CYCLE TRACK LIMITS AND REPLACE ALL OF THEM FROM THE CURB TO THE MAIN SEWER. INVESTIGATION OF SIDE SEWERS SHALL BE COMPLETED PER CONTRACT SPECIFICATIONS PRIOR TO REPLACEMENT WORK.
4. CONTRACTOR SHALL NOTIFY CITY REPRESENTATIVE IF EXISTING SIDE SEWER CONNECTIONS ARE DEFECTIVE. IF DETERMINED BY CITY REPRESENTATIVE THAT THE CONNECTION REQUIRES REPLACEMENT, SIDE SEWER CONNECTION TO RC SEWERS/RCP/BRICK SHALL BE CONSTRUCTED PER DETAILS ON SW-4. SIDE SEWER CONNECTIONS TO VCP SHALL BE PER CONTRACT SPECIFICATIONS. CITY REPRESENTATIVE MAY ALSO REQUIRE CONTRACTOR TO LINE (E) SIDE SEWERS WITH CIP.

20' 0 20' 40'  
HORIZONTAL SCALE: 1"=20'

5' 0 5' 10'  
VERTICAL SCALE: 1"=5'

ELEVATION  
DATUM  
SFVD13

FOR ORIGINAL STAMP AND SIGNATURES,  
SEE DWG SW-5 REV. NO. 0

NO.	DATE	DESCRIPTION	BY	APP.
0	09/16	UTILITY CONFLICTS	TW	LW
1	10/16	ISSUED FOR BIDS	AS	LW

TABLE OF REVISIONS


REFERENCE INFORMATION & FILE NO. OF SURVEYS
74,105 55,291



DESIGN &  
ENGINEERING  
CITY & COUNTY OF SAN FRANCISCO  
SAN FRANCISCO PUBLIC WORKS  
30 VAN NESS AVENUE, 6TH FLOOR  
SAN FRANCISCO, CA 94102-6028

Section Mgr:	LESLIE WONG
Deputy Division Mgr:	IOBAL DHAPA
Division Mgr:	PATRICK RIVERA

DESIGNED: DATE:	J.K./A.S. 11/2016
DRAWN: DATE:	A.KIRSCH 11/2016
CHECKED: DATE:	G.FONG 11/2016

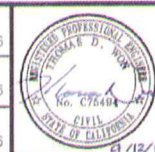

SCALE:  
AS NOTED  
SHEET OF SHEETS

2ND STREET STREETSCAPE  
IMPROVEMENTS PROJECT  
2ND STREET SEWER REPLACEMENT  
STATION 22+00 TO 27+50  
PLAN AND PROFILE

CONTRACT NO.	1064J
DRAWING NO.	SW-5
FILE NO.	
REV. NO.	1

SW-2=1  
SW-6=3  
SW-21=1  
SW-24=29 LF.  
SW-27=89 LF.  
SW-30=4.