

TRAFFIC CONTROL PLAN
1064J - 2ND ST IMPROVEMENTS PROJECT
GRIND AND PAVE WORK PLAN - 2ND ST FROM BRYANT ST TO TOWNSEND ST

- ☒ NO EXCEPTIONS TAKEN
- ☒ MAKE CORRECTIONS NOTED
- ☒ REJECTED
- ☒ REVISE AND RESUBMIT
- ☒ SUBMIT SPECIFIED ITEM(S)


Review is only for general conformance with the design concept of the project and general compliance with the requirements of the contract documents. Any action shown is subject to the requirements of the plans and specifications. Contractor's responsibilities include, but are not limited to actual dimensions which shall be confirmed and correlated at the job site; preferred fabrication processes and techniques of construction; coordination of the contractor's work with that of all other trades; and the satisfactory performance of the contractor's work.

San Francisco Engineering Division
Department of Parking and Traffic
City and County of San Francisco

By: *[Signature]* Date: 5/8/19



Plan Scale
1" = 50'

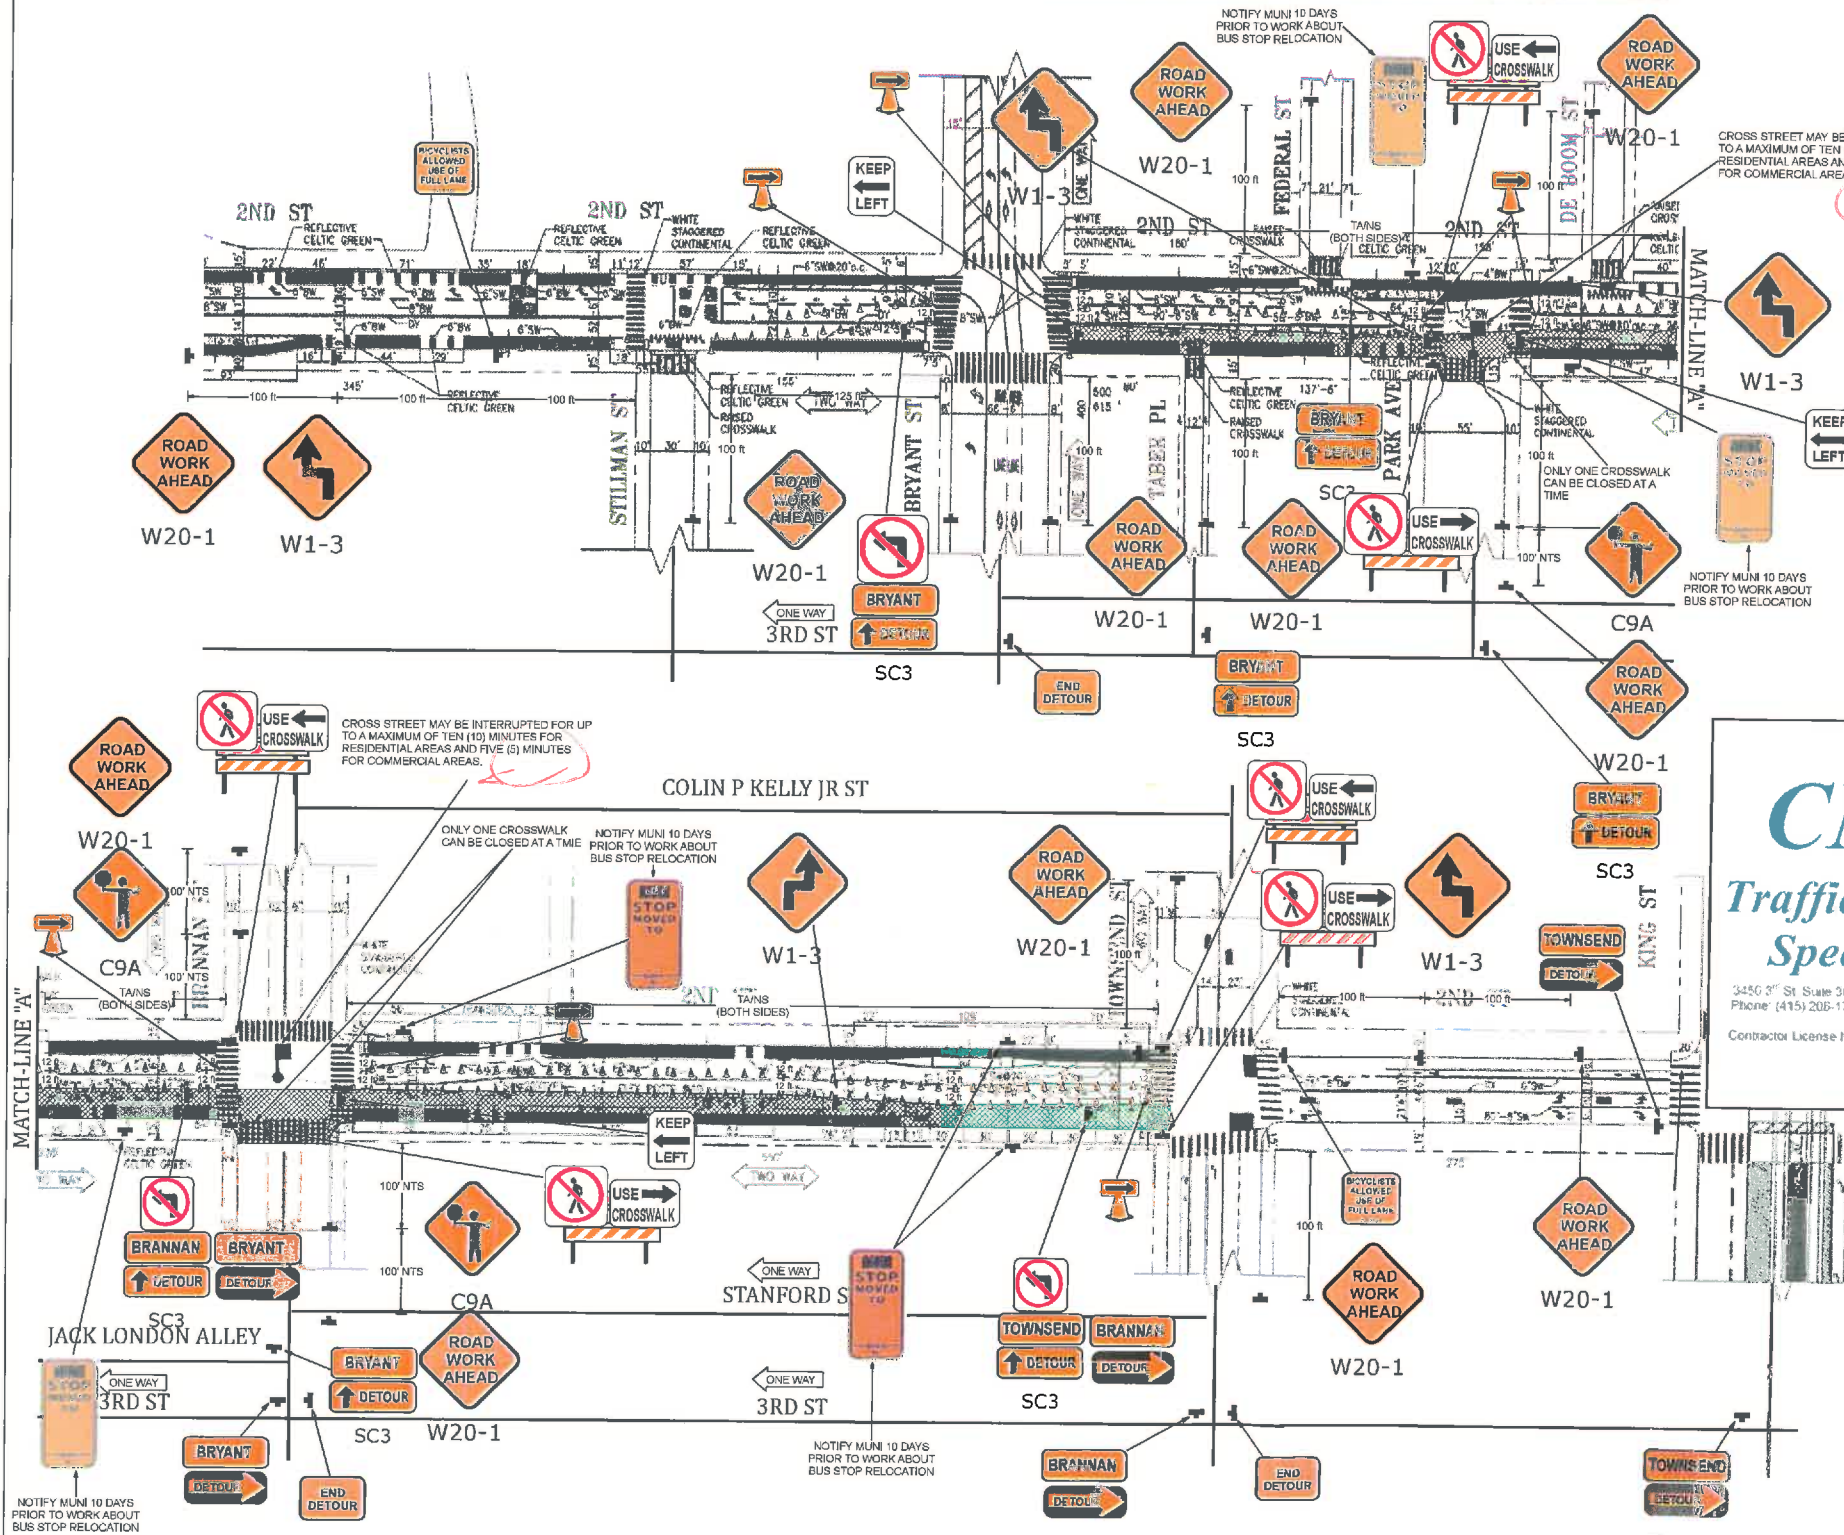

CMC
Traffic Control Specialists
3450 3rd St Suite 3G, San Francisco, CA 94124
Phone: (415) 206-1700 Fax: (415) 206-1711
Contractor License No. 792059 (Class A & C-31)

- Date: 04/05/2019 Author: PM/RC Project: 1064J
Client: M2 Owner: SFPD/PTW Location: SAN FRANCISCO
TCP: 069 CMC Job #: 1430
- Comments:
- 1) WORK HOURS:
 - 2) CONTRACTOR TO VERIFY EXISTING STRIPING IS ACCURATE PRIOR TO START OF WORK.
 - 3) ALL TRAFFIC CONTROL SHALL CONFORM TO THE LATEST EDITION OF CA MUTCD.
 - 4) ALL TRAFFIC CONTROL DEVICES SHALL BE RETROREFLECTIVE IF SETUP DURING HOURS OF DARKNESS.
 - 5) GRINDING AND/OR PAVING WORK WILL BE ALLOWED UP TO TWO (2) CONSECUTIVE BLOCKS AND TWO (2) CONSECUTIVE INTERSECTIONS MAXIMUM AT A TIME AND ALL TWO (2) CONSECUTIVE BLOCKS AND TWO (2) CONSECUTIVE INTERSECTIONS MUST BE PAVED WITHIN 72 HOURS FROM THE START OF GRINDING WORK, WITHOUT EXCEPTION.
 - 6) DURING INTERSECTION GRINDING AND PAVING WORK, THE CROSS STREET MAY BE INTERRUPTED FOR UP TO A MAXIMUM OF TEN (10) MINUTES FOR RESIDENTIAL AREAS AND FIVE (5) MINUTES FOR COMMERCIAL AREAS. HOWEVER, CONTRACTOR MUST ALLOW ALL MUNI BUSES TO PASS THROUGH THE INTERSECTION WITHOUT ANY DELAY.

STREET	TIME	NORTHBOUND	SOUTHBOUND	EASTBOUND	WESTBOUND
2ND STREET					
Marked 2nd to King St	8:00A - 6PM (M-F) 8:00A - 6PM (S-S) At Other Times	10:12 10:12 Full Roadway	10:12 10:12 Full Roadway		
Cross Streets for 2nd Street					
Townsend St	8:00A - 6PM (M-F) 8:00A - 6PM (S-S) At Other Times			Closed Closed Full Roadway	
Brannan St	8:00A - 6PM (M-F) 8:00A - 6PM (S-S) At Other Times			Closed Closed Full Roadway	
Stanford St	8:00A - 6PM (M-F) 8:00A - 6PM (S-S) At Other Times			Closed Closed Full Roadway	
Jack London Alley	8:00A - 6PM (M-F) 8:00A - 6PM (S-S) At Other Times			Closed Closed Full Roadway	
3rd St	8:00A - 6PM (M-F) 8:00A - 6PM (S-S) At Other Times			Closed Closed Full Roadway	
Colin P Kelly Jr St	8:00A - 6PM (M-F) 8:00A - 6PM (S-S) At Other Times			Closed Closed Full Roadway	
King St	8:00A - 6PM (M-F) 8:00A - 6PM (S-S) At Other Times			Closed Closed Full Roadway	