



**PLAN**  
SCALE: 1"=20'

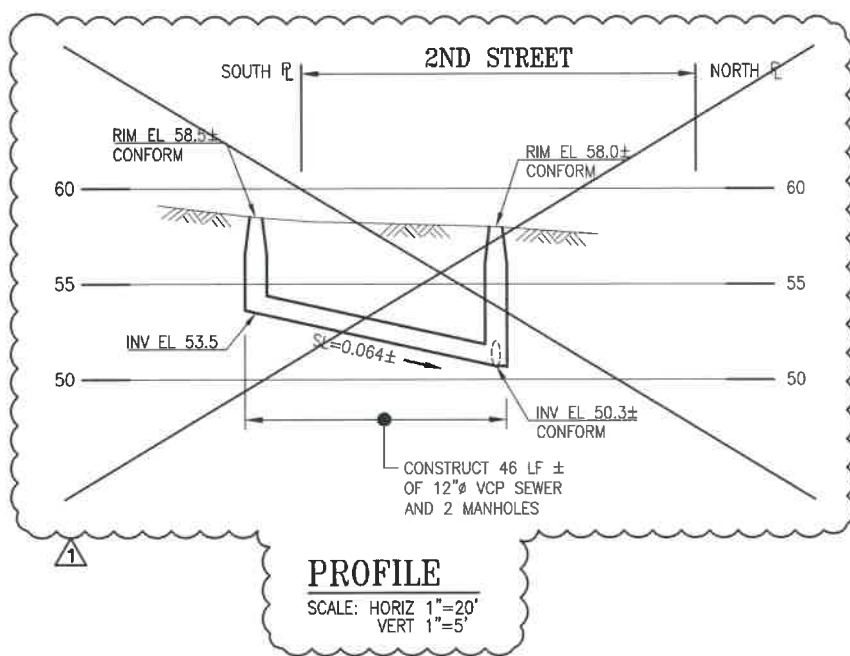

**PROFILE**  
SCALE: HORIZ 1"=20'  
VERT 1"=5'

**NOTES:**

1. CONTRACTOR SHALL ADJUST MANHOLE FRAMES AND COVERS TO PROPOSED GRADES. REFER TO R-DWGS FOR PROPOSED ELEVATIONS.
2. SEE R-DWGS FOR PROPOSED ROADWAY IMPROVEMENTS INCLUDING, BUT NOT LIMITED TO, RAISED CROSSWALKS, BUS ISLANDS, AND VARIOUS BUFFER ZONES.
3. CONTRACTOR TO IDENTIFY ALL ACTIVE SIDE SEWERS WITHIN RAISED CYCLE TRACK LIMITS AND REPLACE ALL OF THEM FROM THE CURB TO THE MAIN SEWER. INVESTIGATION OF SIDE SEWERS SHALL BE COMPLETED PER CONTRACT SPECIFICATIONS PRIOR TO REPLACEMENT WORK.
4. CONTRACTOR SHALL NOTIFY CITY REPRESENTATIVE IF EXISTING SIDE SEWER CONNECTIONS ARE DEFECTIVE. IF DETERMINED BY CITY REPRESENTATIVE THAT THE CONNECTION REQUIRES REPLACEMENT, SIDE SEWER CONNECTION TO RC SEWERS/RCP/BRICK SHALL BE CONSTRUCTED PER DETAILS ON SW-4. SIDE SEWER CONNECTIONS TO VCP SHALL BE PER CONTRACT SPECIFICATIONS. CITY REPRESENTATIVE MAY ALSO REQUIRE CONTRACTOR TO LINE (E) SIDE SEWERS WITH CIPL.

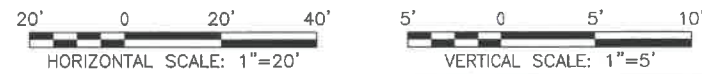

ELEVATION DATUM SFVD13

FOR ORIGINAL STAMP AND SIGNATURES, SEE DWG SW-5 REV. NO. 0

NO.	DATE	DESCRIPTION	BY	APP.
09/18	UTILITY CONFLICTS	TW	LW	
10/16	ISSUED FOR BIDS	AS	LW	

REFERENCE INFORMATION & FILE NO. OF SURVEYS
74,108 55,291



**DESIGN & ENGINEERING**  
CITY & COUNTY OF SAN FRANCISCO  
SAN FRANCISCO PUBLIC WORKS  
30 VAN NESS AVENUE, 6TH FLOOR  
SAN FRANCISCO, CA 94102 - 8028

Section Mgr:	LESLEY WONG
Deputy Division Mgr:	IQBAL DHAPA
Division Mgr:	PATRICK RIVERA

DESIGNED:	DATE:
J.K./A.S.	11/2016
DRAWN:	DATE:
A.KIRSCH	11/2016
CHECKED:	DATE:
G.FONG	11/2016



SCALE:	AS NOTED
SHEET OF SHEETS	

**2ND STREET STREETSCAPE IMPROVEMENTS PROJECT**

**2ND STREET SEWER REPLACEMENT STATION 22+00 TO 27+50**

**PLAN AND PROFILE**

CONTRACT NO.	1064J
DRAWING NO.	SW-5
FILE NO.	
REV. NO.	1