


TRAFFIC CONTROL PLAN
1064J - 2ND ST IMPROVEMENTS PROJECT
STORAGE PLAN

www.invision.com

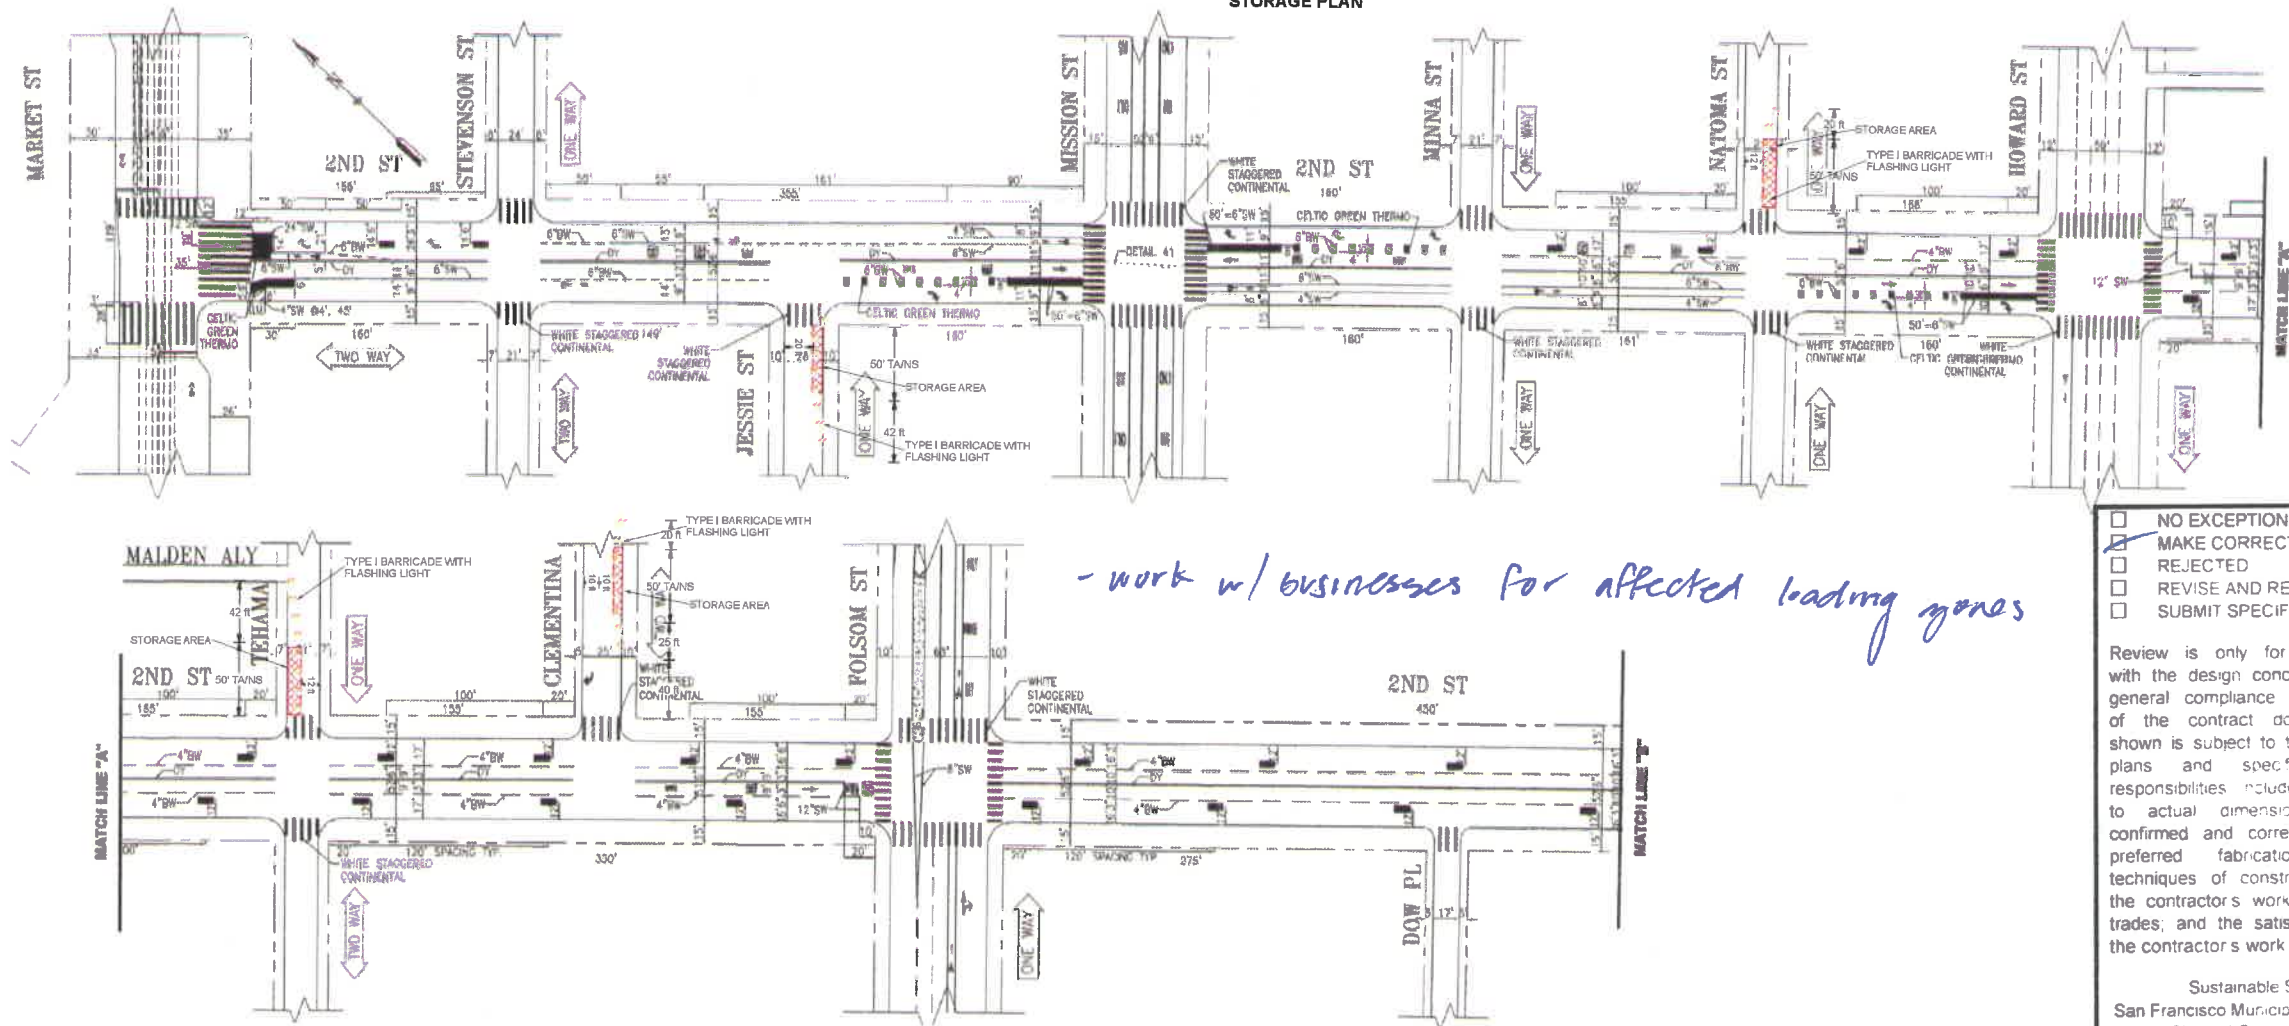

- work w/ businesses for affected loading zones

- ☐ NO EXCEPTIONS TAKEN
- ☒ MAKE CORRECTIONS NOTED
- ☐ REJECTED
- ☐ REVISE AND RESUBMIT
- ☐ SUBMIT SPECIFIED ITEM(S)

Review is only for general conformance with the design concept of the project and general compliance with the requirements of the contract documents. Any action shown is subject to the requirements of the plans and specifications. Contractors responsibilities include but are not limited to actual dimensions which shall be confirmed and correlated at the job site; preferred fabrication processes and techniques of construction; coordination of the contractors work with that of all other trades; and the satisfactory performance of the contractor's work.


Sustainable Streets Division
San Francisco Municipal Transportation Agency
City and County of San Francisco

By CP Date 11/16/17

- Legend**
- Type III Barricade
 - 28" Traffic Cone
 - Work Area
 - Sign and Stand
 - Direction of Travel
 - Type III Barricade (Plan View)
 - Water Filled Barrier
 - NTS Not To Scale
 - TANG Tow-Away/No Stopping
 - Police Officer
 - Flagger
 - Type I Barricade
 - Work Truck
 - Pipe to be installed
 - Existing Utility
 - Flashing Beacon



Plan Scale
1" = 50'

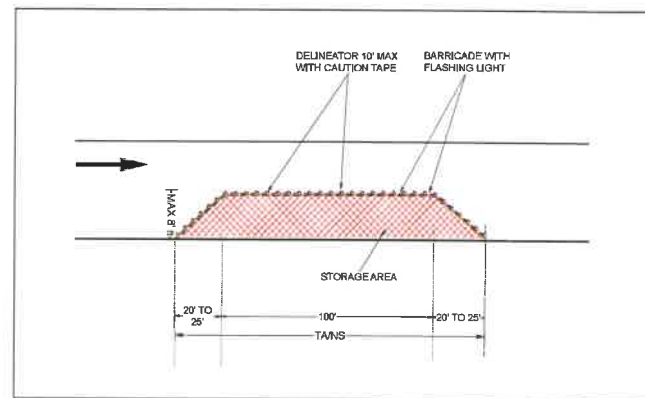

EQUIPMENT STAGING AREA
(NOT TO SCALE)
"DO NOT BLOCK DRIVEWAYS ACCESS"

CMC
Traffic Control
Specialists

3450 3rd St, Suite 3G, San Francisco, CA 94124
Phone (415) 206-1700 Fax (415) 206-1711

Contractor License No. 792069 (Class A & C-31)

Date: 10/16/2017 Author: PM/RC Project: 1064J
Client: M2 Owner: SFPD Location: SAN FRANCISCO
TCP: 013 CMC Job #: 1430 REV: 0

Comments:

- 1) NO CONSTRUCTION EQUIPMENT AND MATERIAL STORAGE, INCLUDING BUT NOT LIMITED TO PIPES, PIPE-FITTING, STEEL BARS, SHORING, BACKFILL, ASPHALT MIX ETC. SHALL BE ALLOWED ON ANY SIDEWALK, STREET OR PROPERTY, EXCEPT AS SHOWN ON THE APPROVED TRAFFIC CONTROL PLANS FOR VARIOUS PHASES OF CONSTRUCTION. A MAXIMUM STORAGE AREA OF 100 FEET IN LENGTH MAY BE ALLOWED PER BLOCK.
- 2) OFFICE/STORAGE TRAILERS SHALL BE AT LEAST 100 FEET FROM ANY INTERSECTION. IT SHALL NOT BLOCK TRAFFIC CONTROL DEVICES (STOP SIGNS, SIGNALS, ETC.) HYDRANTS, BUS STOPS, OR DRIVEWAYS.
- 3) STORAGE, STOCKPILING, OR PLACEMENT SHALL NOT IN ANY WAY OBSTRUCT ANY LANE OR PASSAGEWAY INTENDED FOR VEHICULAR OR PEDESTRIAN TRAFFIC.
- 4) IF PARKING METERS ARE TO BE OCCUPIED FOR EQUIPMENT/MATERIAL STORAGE IN THE VICINITY OF THE ACTIVE CONSTRUCTION AREA, THE CONTRACTOR SHALL APPLY FOR A SPECIAL TRAFFIC PERMIT AND PAY FOR ALL APPLICABLE FEES. SEE ARTICLE 3.5 FOR SPECIAL TRAFFIC PERMIT FOR MORE INFORMATION.