





MATCH LINE "D", STA 22+00  
SEE SHEET SW-4

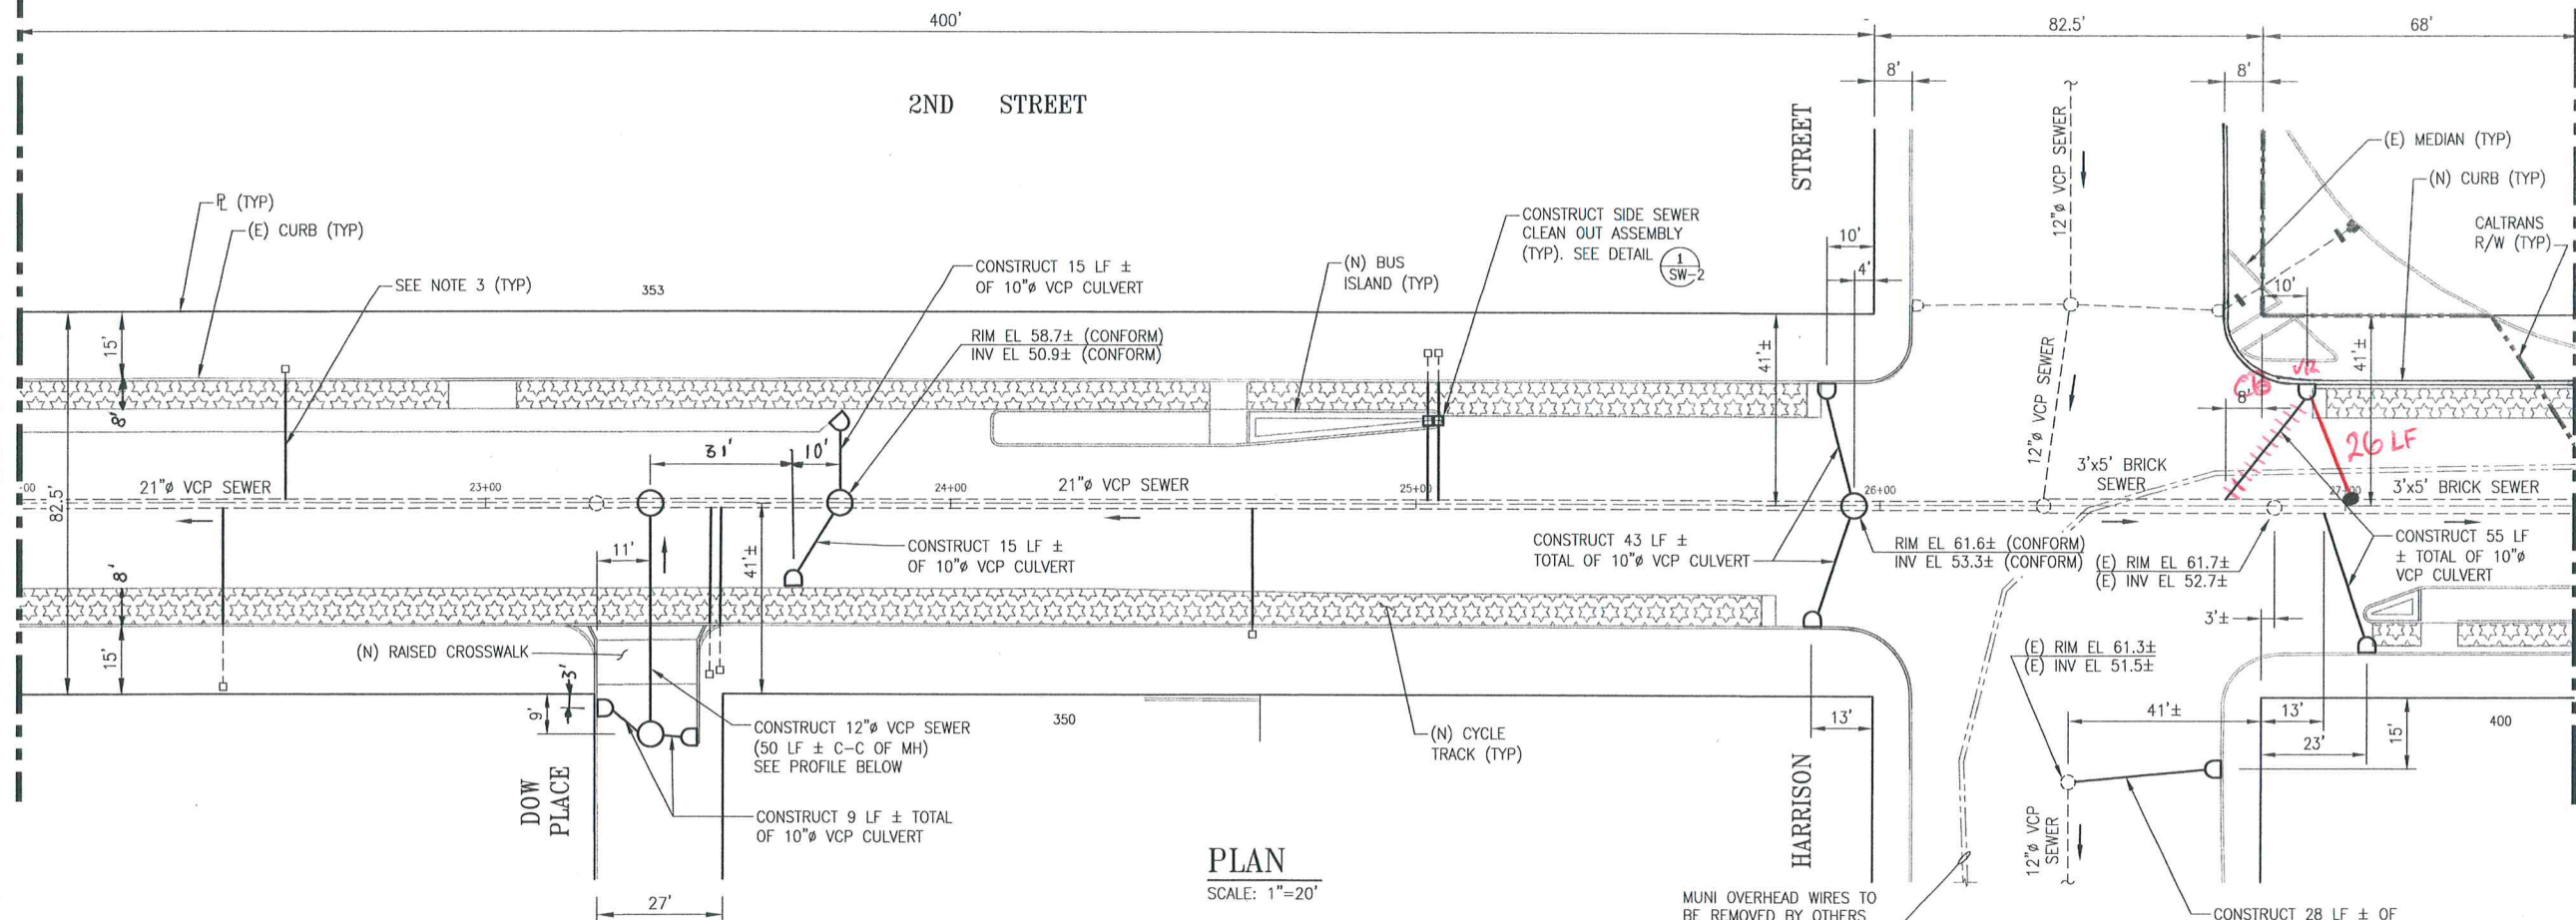

PLAN  
SCALE: 1"=20'

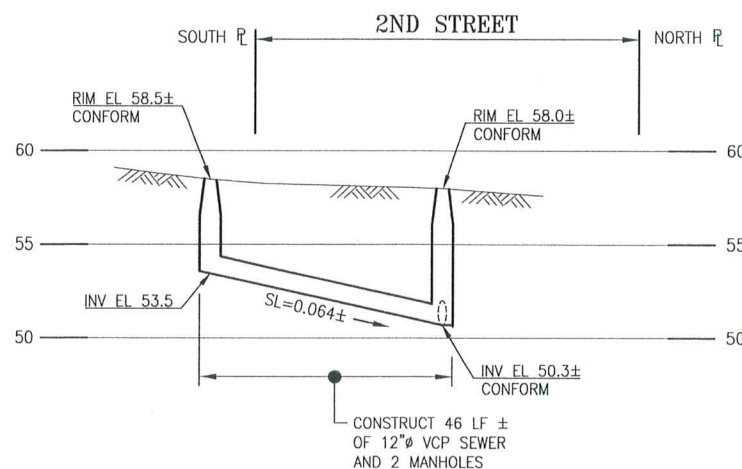

PROFILE  
SCALE: HORIZ 1"=20'  
VERT 1"=5'

NOTES:


- CONTRACTOR SHALL ADJUST MANHOLE FRAMES AND COVERS TO PROPOSED GRADES. REFER TO R-DWGS FOR PROPOSED ELEVATIONS.
- SEE R-DWGS FOR PROPOSED ROADWAY IMPROVEMENTS INCLUDING, BUT NOT LIMITED TO, RAISED CROSSWALKS, BUS ISLANDS, AND VARIOUS BUFFER ZONES.
- CONTRACTOR TO IDENTIFY ALL ACTIVE SIDE SEWERS WITHIN RAISED CYCLE TRACK LIMITS AND REPLACE ALL OF THEM FROM THE CURB TO THE MAIN SEWER. INVESTIGATION OF SIDE SEWERS SHALL BE COMPLETED PER CONTRACT SPECIFICATIONS PRIOR TO REPLACEMENT WORK.
- CONTRACTOR SHALL NOTIFY CITY REPRESENTATIVE IF EXISTING SIDE SEWER CONNECTIONS ARE DEFECTIVE. IF DETERMINED BY CITY REPRESENTATIVE THAT THE CONNECTION REQUIRES REPLACEMENT, SIDE SEWER CONNECTION TO RC SEWERS/RCP/BRICK SHALL BE CONSTRUCTED PER DETAILS ON SW-4. SIDE SEWER CONNECTIONS TO VCP SHALL BE PER CONTRACT SPECIFICATIONS. CITY REPRESENTATIVE MAY ALSO REQUIRE CONTRACTOR TO LINE (E) SIDE SEWERS WITH CIPL.



ELEVATION  
DATUM  
SFVD13

NO.	DATE	DESCRIPTION	BY	APP.
0	10/16	ISSUED FOR BIDS	AS	LW

REFERENCE INFORMATION  
& FILE NO. OF SURVEYS  
74,108  
55,291

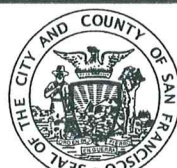

DESIGN &  
ENGINEERING  
CITY & COUNTY OF SAN FRANCISCO  
SAN FRANCISCO PUBLIC WORKS  
30 VAN NESS AVENUE, 5TH FLOOR  
SAN FRANCISCO, CA 94102 - 6028

Section Mgr.	LESLEY WONG	Date:	11/1/16
Deputy Division Mgr.	IQBAL DHAPA	11/1/16	
Division Mgr.	PATRICK RIVERA	11/1/16	

DESIGNED:	DATE:
J.K./A.S.	11/2016
DRAWN:	DATE:
A.KIRSCH	11/2016
CHECKED:	DATE:
G.FONG	11/2016



SCALE:  
AS NOTED  
SHEET OF SHEETS

2ND STREET STREETSCAPE  
IMPROVEMENTS PROJECT  
2ND STREET SEWER REPLACEMENT  
STATION 22+00 TO 27+50  
PLAN AND PROFILE

CONTRACT NO.	1064J(R)
DRAWING NO.	SW-5
FILE NO.	106,247
REV. NO.	0