


NOTES:

- CONTRACTOR SHALL ADJUST MANHOLE FRAMES AND COVERS TO PROPOSED GRADES. REFER TO R-DWGS FOR PROPOSED ELEVATIONS.
- SEE R-DWGS FOR PROPOSED ROADWAY IMPROVEMENTS INCLUDING, BUT NOT LIMITED TO, RAISED CROSSWALKS, BUS ISLANDS, AND VARIOUS BUFFER ZONES.
- CONTRACTOR TO IDENTIFY ALL ACTIVE SIDE SEWERS WITHIN RAISED CYCLE TRACK LIMITS AND REPLACE ALL OF THEM FROM THE CURB TO THE MAIN SEWER. INVESTIGATION OF SIDE SEWERS SHALL BE COMPLETED PER CONTRACT SPECIFICATIONS PRIOR TO REPLACEMENT WORK.
- CONTRACTOR SHALL NOTIFY CITY REPRESENTATIVE IF EXISTING SIDE SEWER CONNECTIONS ARE DEFECTIVE. IF DETERMINED BY CITY REPRESENTATIVE THAT THE CONNECTION REQUIRES REPLACEMENT, SIDE SEWER CONNECTION TO HO SEWERS/VCP/BRICK SHALL BE CONSTRUCTED PER DETAILS ON SW-4. SIDE SEWER CONNECTIONS TO VCP SHALL BE PER CONTRACT SPECIFICATIONS. CITY REPRESENTATIVE MAY ALSO REQUIRE CONTRACTOR TO LINE (E) SIDE SEWERS WITH CIP.
- REPLACE (E) MANHOLE W/ MODIFIED MANHOLE FOR 3" x 5" BRICK SEWERS PER STD PLAN 87.182 AND 87.184.

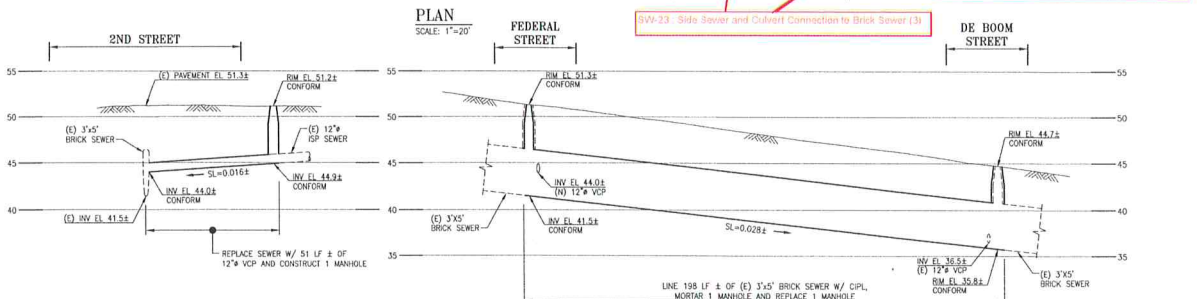

ELEVATION
DATUM
SFVD13

SEWER SIZED BY B.A. 229	APPROVED BY B.S. 85
NO.	DATE
13	10/16
ISSUED FOR BIDS	AS L.W.
DESCRIPTION	BY APP.
TABLE OF REVISIONS	

REFERENCE INFORMATION
& FILE NO. OF SURVEYS
229



DESIGN & ENGINEERING
CITY & COUNTY OF SAN FRANCISCO
SAN FRANCISCO PUBLIC WORKS
30 VANDERBILT AVENUE, 27TH FLOOR
SAN FRANCISCO, CA 94102-4002

DESIGNED BY Lesley Wong	DESIGNED DATE 11/11/16
CHECKED BY Lesley Wong	CHECKED DATE 11/14/16
DESIGNED BY Lesley Wong	DESIGNED DATE 11/11/16
CHECKED BY Lesley Wong	CHECKED DATE 11/14/16

DESIGNED BY Lesley Wong	DESIGNED DATE 11/11/16
CHECKED BY Lesley Wong	CHECKED DATE 11/14/16
DESIGNED BY Lesley Wong	DESIGNED DATE 11/11/16
CHECKED BY Lesley Wong	CHECKED DATE 11/14/16



SCALE: AS NOTED	SHEET OF SHEETS 1 OF 1
--------------------	---------------------------

2ND STREET STREETSCAPE IMPROVEMENTS PROJECT 2ND STREET SEWER REPLACEMENT STATION 32+00 TO 37+50 PLAN AND PROFILES	CONTRACT NO. 10644 (P) DRAWING SET SW-7 FILE NO. 10644 REV. 0
---	--

Handwritten signature: Leslie Wong
Handwritten date: 11/14/16