R-5 QTYs measured 9/22/2020 (continued)

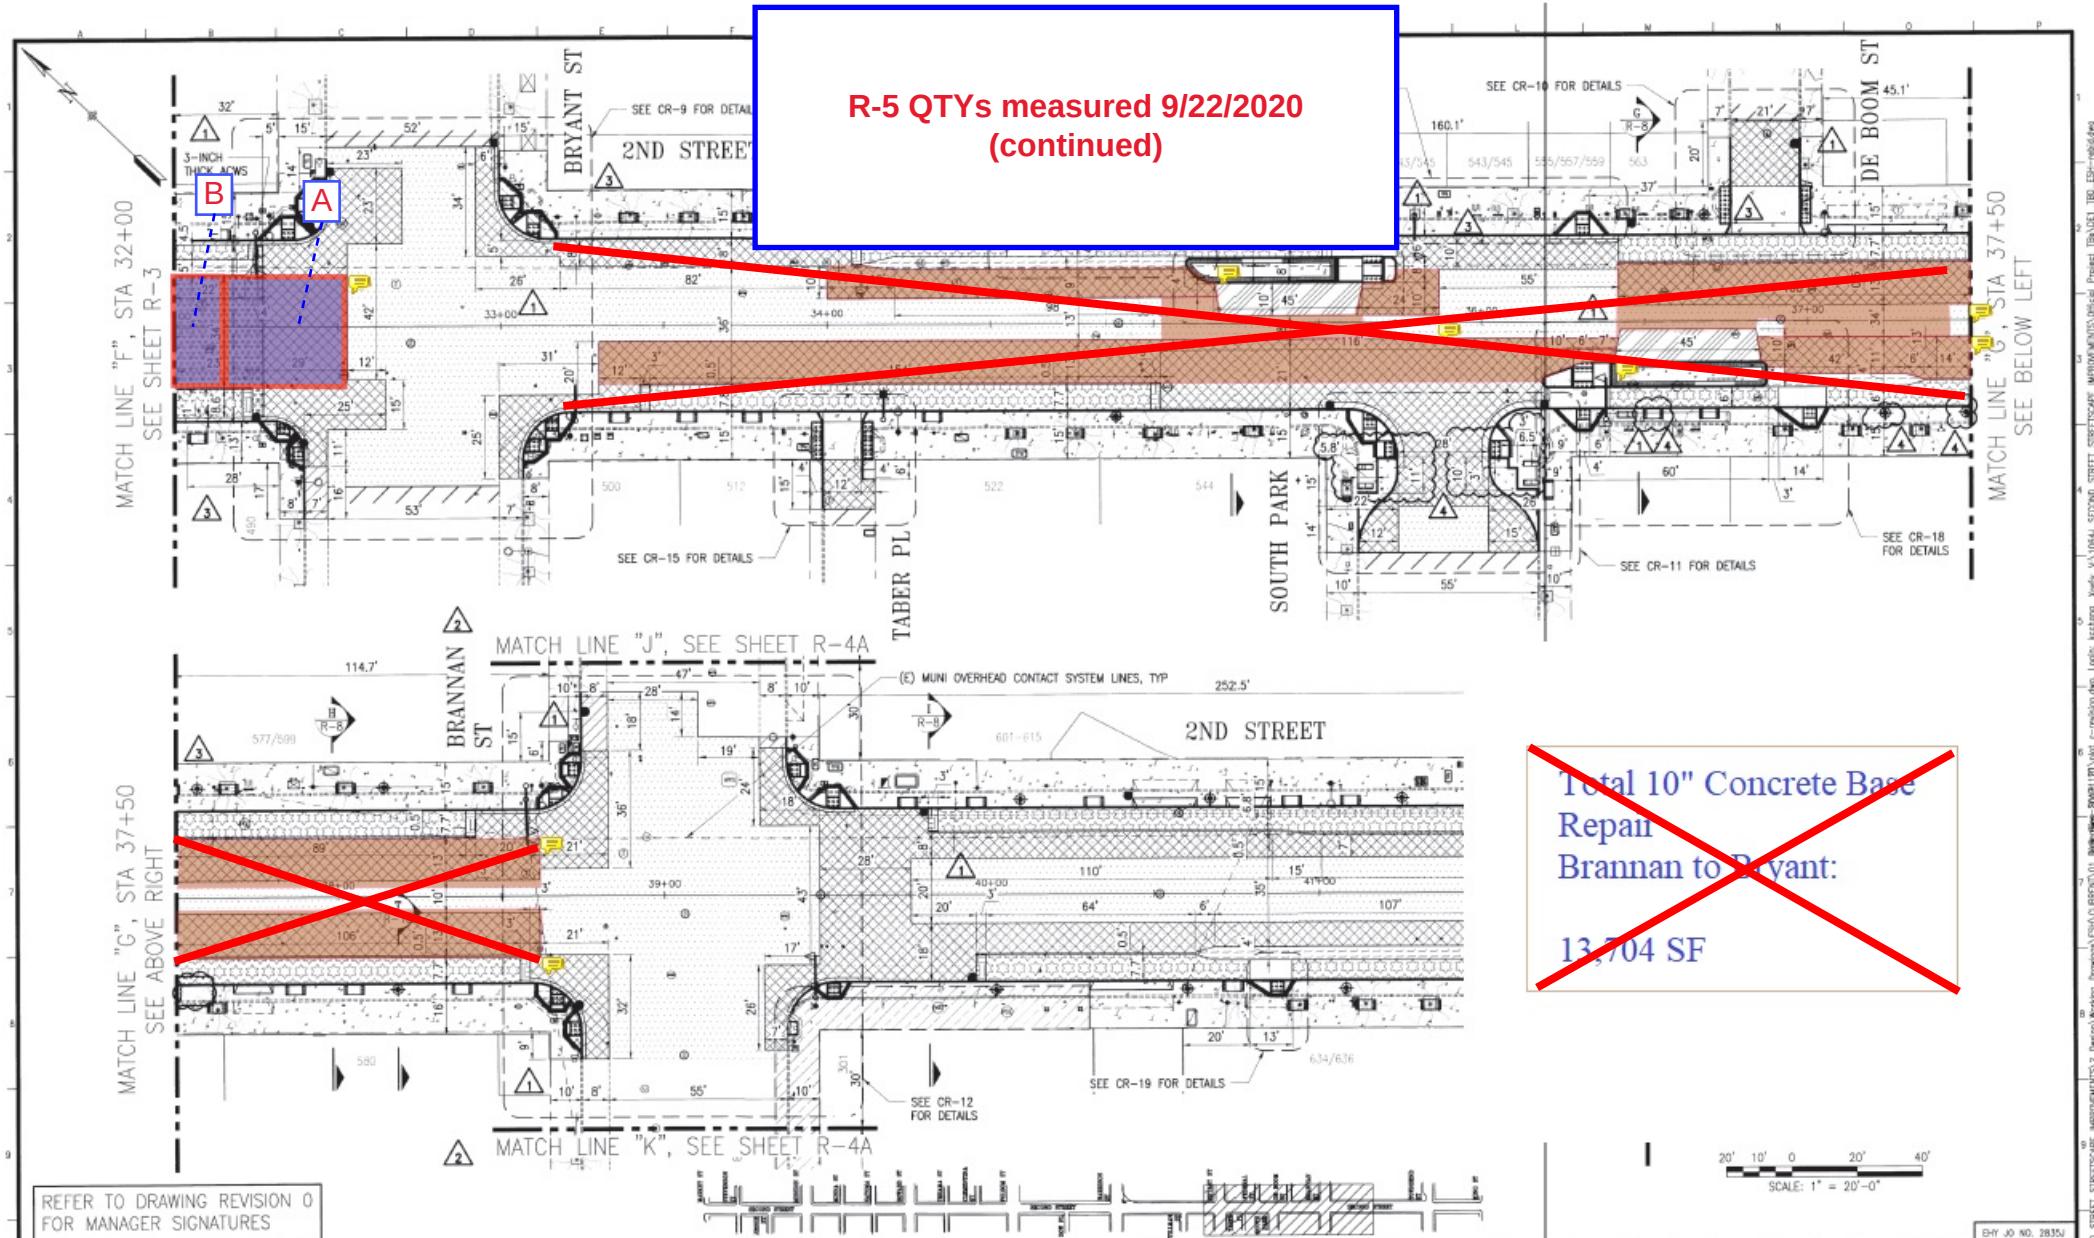

~~Total 10" Concrete Base Repair Brannan to Bryant:~~

~~13,704 SF~~

REFER TO DRAWING REVISION 0 FOR MANAGER SIGNATURES

SCALE: 1" = 20'-0"

NO.	DATE	DESCRIPTION	BY	APP.
4	11/19	INCREASE SIDEWALK PAD SIZE IN PLANTER AND REVISE TREE AND POLE LAYOUT	KC	DMC
3	03/19	PCO #28	YL	KC
2	03/19	ADD BRANNAN ST PAVING WORK	YL	KC
1	05/18	REVISE BUS PAD LAYOUT, 3-INCH ACWS, GRADING, & DRAINAGE	KC	DMC

TABLE OF REVISIONS

THIS DRAWING WAS LAST MODIFIED: 01/23/20 08:44, BY: kochang

REFERENCE INFORMATION & FILE NO. OF SURVEYS

SEAL OF THE CITY AND COUNTY OF SAN FRANCISCO

SAN FRANCISCO PUBLIC WORKS

BUREAU OF DESIGN & ENGINEERING
PUBLIC WORKS
CITY & COUNTY OF SAN FRANCISCO
30 VAN NESS AVENUE, 5TH FLOOR
SAN FRANCISCO, CA 94102 - 6026

Acting Section Mgr: ERIC KJELSBERG
Deputy Division Mgr: FERNANDO CISNEROS
Division Mgr: PATRICK RIVERA

DESIGNED: K.CHANG 11/19
DRAWN: K.CHANG 11/19
CHECKED: D.CALLEROS 11/19

REGISTERED PROFESSIONAL ENGINEER DOMINIC C. CALLEROS No. C87180 CIVIL STATE OF CALIFORNIA

SCALE: 1" = 20'

SHEET OF SHEETS

SECOND STREET IMPROVEMENT PROJECT

PAVEMENT PLAN
2ND STREET
STATION 32+00 TO 42+00

EHY JO NO. 2835J

CONTRACT NO. 1064J (R)

DRAWING NO. R-4

FILE NO. 106,162

REV. NO. 4