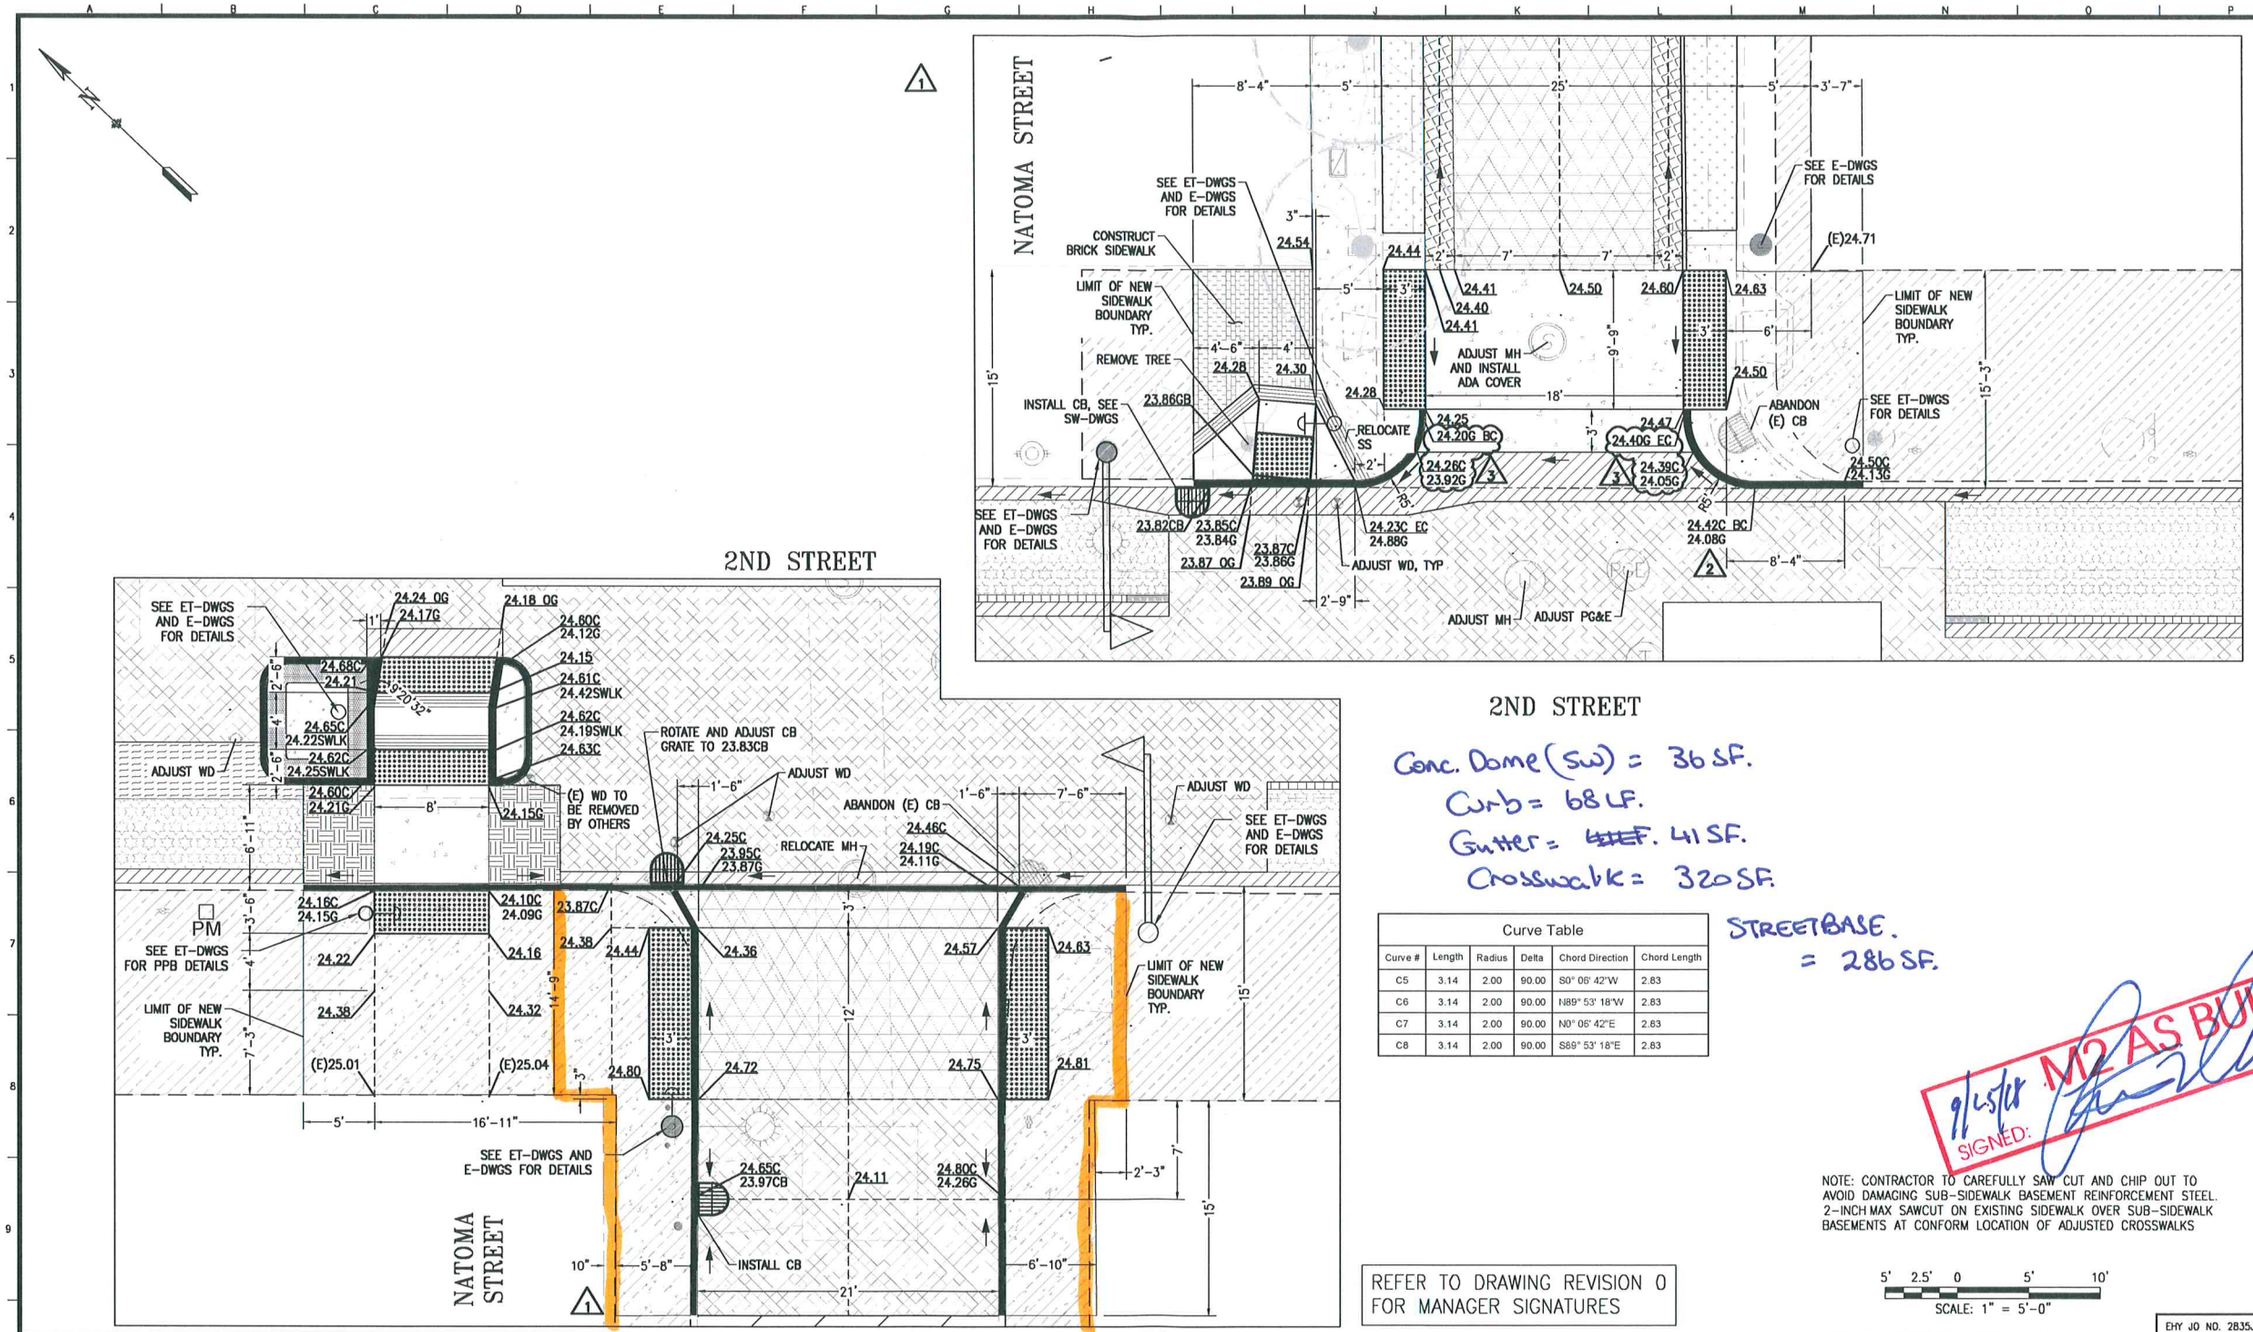

R-19 = 36SF.
R-7 = 68 LF.
R-9 = 41SF.
R-13 = 320SF.
R-5 = 286 SF.

Conc. Dome (SW) = 36 SF.
Curb = 68 LF.
Gutter = ~~41LF~~. 41 SF.
Crosswalk = 320 SF.

STREETBASE.
= 286 SF.

Curve Table					
Curve #	Length	Radius	Delta	Chord Direction	Chord Length
C5	3.14	2.00	90.00	S0° 06' 42"W	2.83
C6	3.14	2.00	90.00	N89° 53' 18"W	2.83
C7	3.14	2.00	90.00	N0° 06' 42"E	2.83
C8	3.14	2.00	90.00	S89° 53' 18"E	2.83

9/5/18 M2 AS BUILT
SIGNED:

NOTE: CONTRACTOR TO CAREFULLY SAW CUT AND CHIP OUT TO AVOID DAMAGING SUB-SIDEWALK BASEMENT REINFORCEMENT STEEL. 2-INCH MAX SAWCUT ON EXISTING SIDEWALK OVER SUB-SIDEWALK BASEMENTS AT CONFORM LOCATION OF ADJUSTED CROSSWALKS

5' 2.5' 0 5' 10'
SCALE: 1" = 5'-0"

REFER TO DRAWING REVISION 0 FOR MANAGER SIGNATURES

NO.	DATE	DESCRIPTION	BY	APP.
3	06/18	REVISE NATOMA EAST CROSSWALK	KC	DMC
2	05/18	REVISE NATOMA EAST CROSSWALK	KC	DMC
1	03/18	NATOMA CROSSWALK REVISIONS	KC	DMC

TABLE OF REVISIONS
THIS DRAWING WAS LAST MODIFIED: 06/01/18 15:11, BY: kcchang

REFERENCE INFORMATION & FILE NO. OF SURVEYS

SEAL OF THE CITY AND COUNTY OF SAN FRANCISCO

SAN FRANCISCO PUBLIC WORKS

DESIGN & ENGINEERING
PUBLIC WORKS
CITY & COUNTY OF SAN FRANCISCO
30 VAN NESS AVENUE, 5TH FLOOR
SAN FRANCISCO, CA 94102 - 6028

Section Mgr: CRISTINA C OLEA
Deputy Division Mgr: FERNANDO CISNEROS
Division Mgr: PATRICK RIVERA
Date:

DESIGNED: K.CHANG DATE: 06/18
DRAWN: K.CHANG DATE: 06/18
CHECKED: D.CALLEROS DATE: 06/18

REGISTERED PROFESSIONAL ENGINEER KIMBERLY C. CHANG No. C83180 CIVIL STATE OF CALIFORNIA

SCALE: 1" = 5'
SHEET OF SHEETS

SECOND STREET IMPROVEMENT PROJECT

2ND STREET
2ND STREET AND NATOMA STREET
RAISED CROSSWALK AND CURB RAMP DETAILS

EHY JO NO. 2835J
CONTRACT NO. 1064J (R)
DRAWING NO. CR-4
FILE NO. 106,190
REV. NO. 3

Drawing Path: V:\1064J_SECOND_STREET_STREETSCAPE_IMPROVEMENTS\2_Design\Working_Drawings\ESH\CURRENT\01_Base_Plans\20181121\plot_cr-revision.dwg, Login: kcchang Xrefs: V:\1064J_SECOND_STREET_STREETSCAPE_IMPROVEMENTS\Official_Project_TBs\DE1_TBD_ESH-rebid.dwg V:\1960J_2ND_STREET_SEWER_REPLACEMENT\2_Design\Working_Drawings\ESH\Current\1960J_U1-U8.dwg V:\1064J_SECOND_STREET_STREETSCAPE_IMPROVEMENTS\2_Design\Working_Drawings\ESH\CURRENT\References\20160302-draft_95%-TS V:\1064J_SECOND_STREET_STREETSCAPE_IMPROVEMENTS\2_Design\Working_Drawings\ALA\Base_Plans\1064J_L_BASE.dwg
Plot Time: Fri, 01 Jun 2018 - 3:28pm Model Units: Feet Measurement Units are English