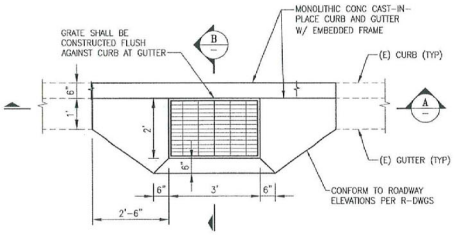

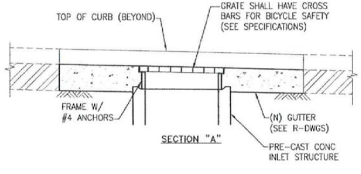

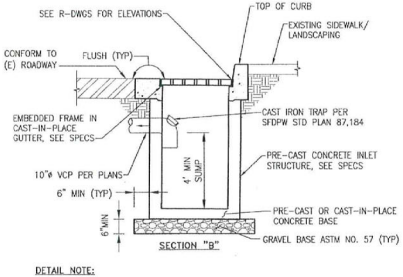

DETAIL NOTE:

REFER TO SFDPW STD PLAN 87,188 AND R-DWGS FOR ALL OTHER DETAILS.

MODIFIED CALTRANS TYPE G3 CATCH BASIN (1)

SCALE: NONE

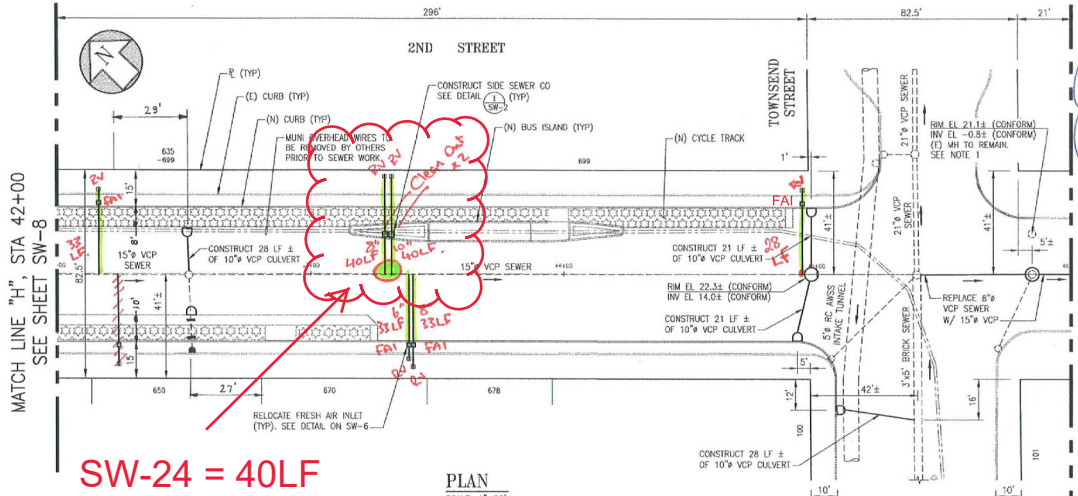

SW-24 = 40LF

SW-27 = -40LF

PLAN

SCALE: 1"=20'

SW-2 = 1
SW-20 = 6
SW-21 = 4
SW-24 = ~~127 LF~~ 167LF
SW-27 = 40 LF
SW-34 = ~~3~~ 4
SW-35 = 2

NOTES:

1. CONTRACTOR SHALL ADJUST MANHOLE FRAMES AND COVERS TO PROPOSED GRADES. REFER TO R-DWGS FOR PROPOSED ELEVATIONS.
2. SEE R-DWGS FOR PROPOSED ROADWAY IMPROVEMENTS INCLUDING, BUT NOT LIMITED TO, RAISED CROSSWALKS, BUS ISLANDS, AND VARIOUS BUFFER ZONES.
3. CONTRACTOR TO IDENTIFY ALL ACTIVE SIDE SEWERS WITHIN RAISED CYCLE TRACK LIMITS AND REPLACE ALL OF THEM FROM THE CURB TO THE RELOCATED FRESH AIR INLET. INVESTIGATION OF SIDE SEWERS SHALL BE COMPLETED PER CONTRACT SPECIFICATIONS PRIOR TO REPLACEMENT WORK.
5. CONTRACTOR SHALL NOTIFY CITY REPRESENTATIVE IF EXISTING SIDE SEWER CONNECTIONS ARE DEFECTIVE. IF DETERMINED BY CITY REPRESENTATIVE THAT THE CONNECTION REQUIRES REPLACEMENT, SIDE SEWER CONNECTION TO RC SEWERS/RCP/BRICK SHALL BE CONSTRUCTED PER DETAILS ON SW-4. SIDE SEWER CONNECTIONS TO VCP SHALL BE PER CONTRACT SPECIFICATIONS. CITY REPRESENTATIVE MAY ALSO REQUIRE CONTRACTOR TO LINE (E) SIDE SEWERS WITH CIPL.

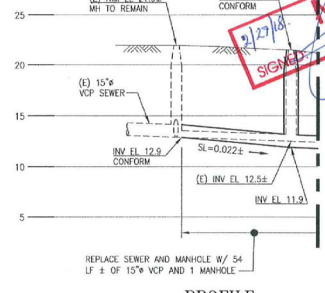

PROFILE

SCALE: HORIZ 1"=20' VERT 1"=5'

HORIZONTAL SCALE: 1"=20' (20' 0 20' 40')

VERTICAL SCALE: 1"=5' (5' 0 5' 10')

M2 AS BUILT SIGNED 9/27/16

ELEVATION DATUM SFVD13	SEWER SIZED BY B.A.	APPROVED BY B.S.

NO.	DATE	DESCRIPTION	BY	APP.
0	10/16	ISSUED FOR BIDS	AS	LW

TABLE OF REVISIONS

REFERENCE INFORMATION & FILE NO. OF SURVEYS: 90,833; 41,274; A-320

SEAL OF THE CITY AND COUNTY OF SAN FRANCISCO

SAN FRANCISCO PUBLIC WORKS

DESIGN & ENGINEERING
CITY & COUNTY OF SAN FRANCISCO
SAN FRANCISCO PUBLIC WORKS
30 VAN NESS AVENUE, 8TH FLOOR
SAN FRANCISCO, CA 94102 - 6028

		Date:
Section Mgr:	LESLEY WONG	11/9/16
Deputy Division Mgr:	IQBAL CHAPA	11/14/16
Division Mgr:	PATRICK RIVERA	11/15/16

DESIGNED: J.K./A.S. DATE: 11/2016
DRAWN: DATE:
A.KIRSCH DATE: 11/2016
CHECKED: G.FONG DATE: 11/2016

REGISTERED PROFESSIONAL ENGINEER CIVIL STATE OF CALIFORNIA 11/9/16

SCALE: AS NOTED

SHEET OF SHEETS

2ND STREET STREETSCAPE IMPROVEMENTS PROJECT

2ND STREET SEWER REPLACEMENT STATION 42+00 TO 46+00 PLAN AND PROFILE

CONTRACT NO. 1064J(R)

DRAWING NO. SW-9

FILE NO. 10 6, 891

REV. NO. 0

EHY JOB ORDER NO. 2835J