SW-2=1
SW-14=164 LF.
SW-21=3.
SW-24= 77 LF.
SW-27=12 LF.
SW-30=4

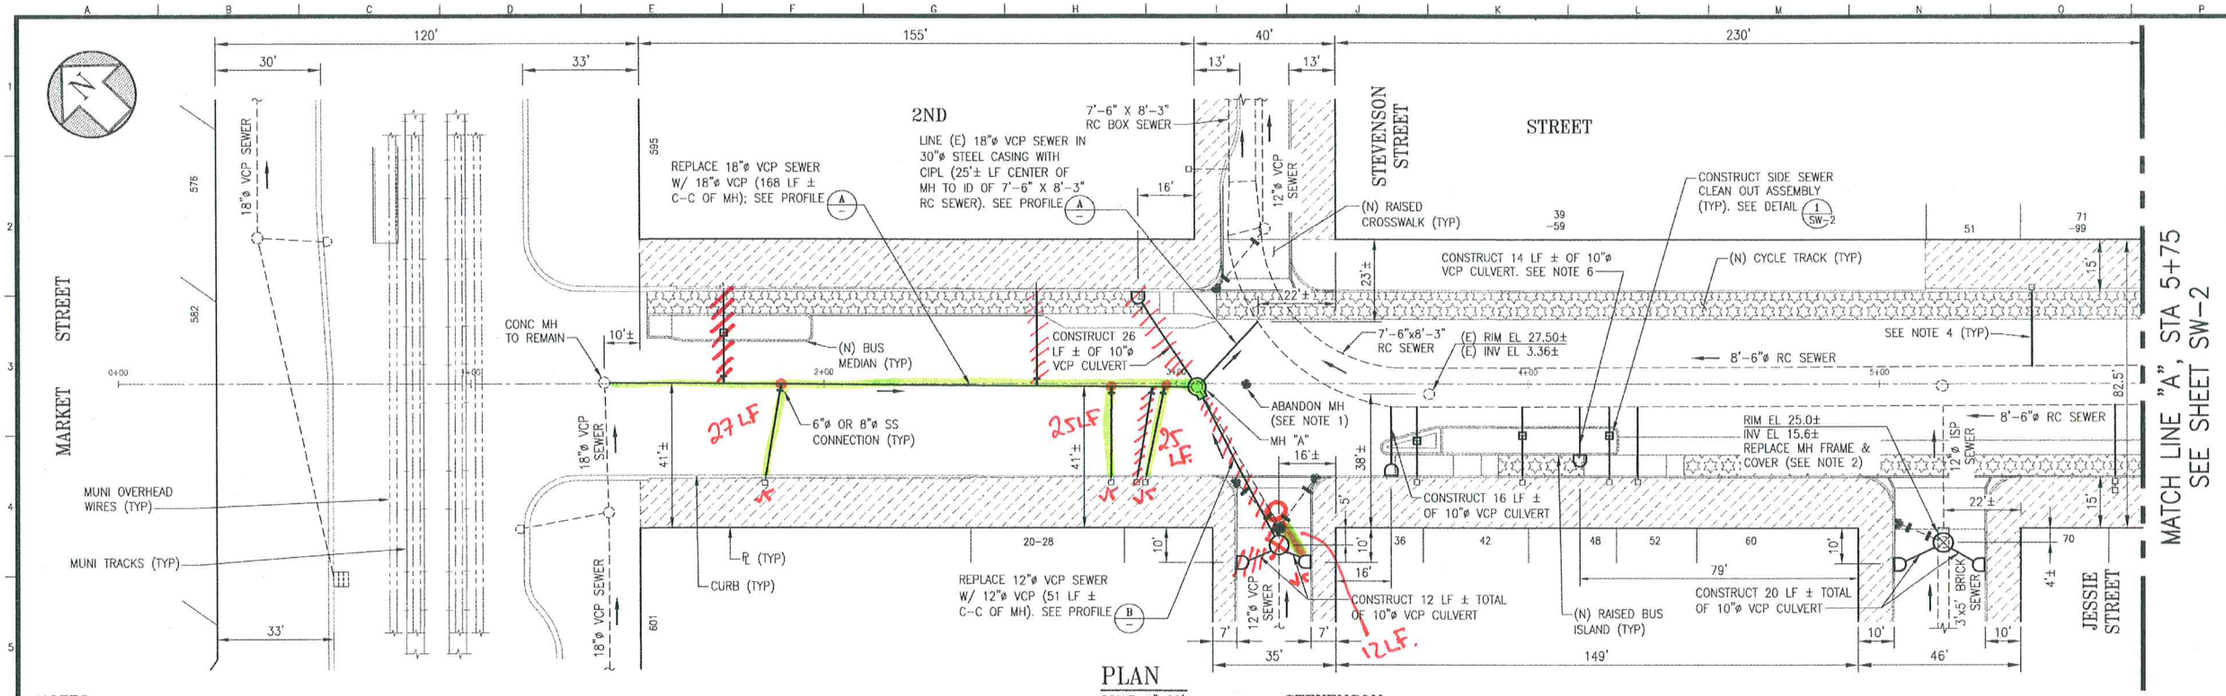

PLAN
SCALE: 1"=20'

NOTES:

1. CONTRACTOR TO ABANDON INACTIVE MH PER DPW STANDARD SPECIFICATIONS.
2. CONTRACTOR SHALL ADJUST MANHOLE FRAMES AND COVERS TO PROPOSED GRADES. REFER TO R-DWGS FOR PROPOSED ELEVATIONS.
3. SEE R-DWGS FOR PROPOSED ROADWAY IMPROVEMENTS INCLUDING, BUT NOT LIMITED TO, RAISED CROSSWALKS, BUS ISLANDS, AND VARIOUS BUFFER ZONES.
4. CONTRACTOR TO IDENTIFY ALL ACTIVE SIDE SEWERS WITHIN RAISED CYCLE TRACK LIMITS AND REPLACE ALL OF THEM FROM THE CURB TO THE MAIN SEWER. INVESTIGATION OF SIDE SEWERS SHALL BE COMPLETED PER CONTRACT SPECIFICATIONS PRIOR TO REPLACEMENT WORK.
5. CONTRACTOR SHALL NOTIFY CITY REPRESENTATIVE IF EXISTING SIDE SEWER CONNECTIONS ARE DEFECTIVE. IF DETERMINED BY CITY REPRESENTATIVE THAT THE CONNECTION REQUIRES REPLACEMENT, SIDE SEWER CONNECTION TO RC SEWERS/RCP/BRICK SHALL BE CONSTRUCTED PER DETAILS ON SW-4. SIDE SEWER CONNECTIONS TO VCP SHALL BE PER CONTRACT SPECIFICATIONS. CITY REPRESENTATIVE MAY ALSO REQUIRE CONTRACTOR TO LINE (E) SIDE SEWERS WITH CIPL.
6. CONTRACTOR SHALL LAYOUT CB AND NEW AWSS LINE PRIOR TO CONSTRUCTION TO CONFIRM CLEARANCE BETWEEN CB AND AWSS LINE. IF LESS THAN 2-FT CLEARANCE, ADJUST OR DELETE CB PER CITY REPRESENTATIVE'S DIRECTION.

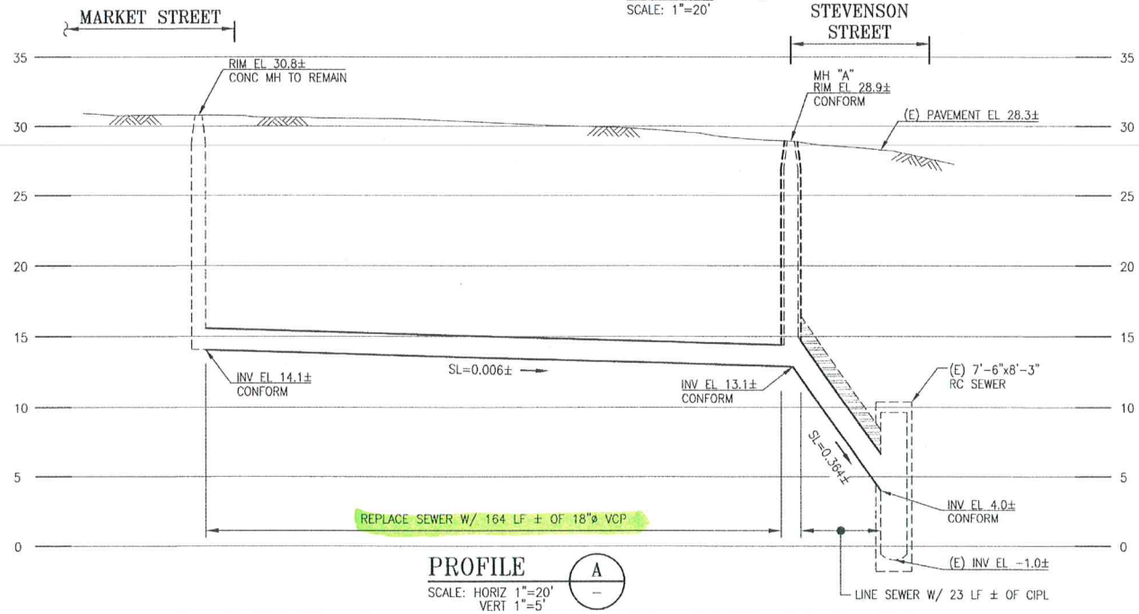

PROFILE A
SCALE: HORIZ 1"=20'
VERT 1"=5'

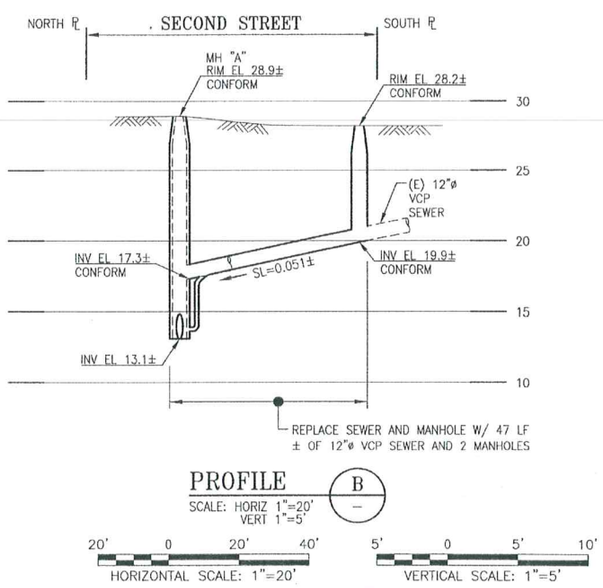

PROFILE B
SCALE: HORIZ 1"=20'
VERT 1"=5'

HORIZONTAL SCALE: 1"=20'
VERTICAL SCALE: 1"=5'

ELEVATION DATUM	SEWER SIZED BY B.A. BA
SFVD13	APPROVED BY B.S. BS

NO.	DATE	DESCRIPTION	BY	APP.
0	10/16	ISSUED FOR BIDS	AS	LW

TABLE OF REVISIONS

REFERENCE INFORMATION & FILE NO. OF SURVEYS
50,158
55,281.7
55,279

SEAL OF THE CITY AND COUNTY OF SAN FRANCISCO

SAN FRANCISCO PUBLIC WORKS

DESIGN & ENGINEERING
CITY & COUNTY OF SAN FRANCISCO
SAN FRANCISCO PUBLIC WORKS
30 VAN NESS AVENUE, 5TH FLOOR
SAN FRANCISCO, CA 94102 - 6028

		Date:
Section Mgr:	LESLEY WONG	11/9/16
Deputy Division Mgr:	IQBAL DHAPA	11/14/16
Division Mgr:	PATRICK RIVERA	11/15/16

DESIGNED:	J.K./A.S. AS	DATE: 11/2016
DRAWN:	A.KIRSCH	DATE: 11/2016
CHECKED:	G.FONG GF	DATE: 11/2016

REGISTERED PROFESSIONAL ENGINEER GENEVIE FONG No. C63661 CIVIL STATE OF CALIFORNIA 11/9/16

SCALE: AS NOTED

SHEET OF SHEETS

2ND STREET STREETSCAPE IMPROVEMENTS PROJECT

2ND STREET SEWER REPLACEMENT
STATION 0+00 TO 5+75
PLAN AND PROFILES

CONTRACT NO. 1064J(R)
DRAWING NO. SW-1
FILE NO. 106,243
REV. NO. 0

EHY JOB ORDER NO. 2835J